

HAR. 055
7-11-63

CODED

WATER WELL DRILLERS LOG

Date: 7-11, 1963, Driller: Sutter Well Works County Harrison

(Name)

(1) Owner of Land: S. L. Madison
(Name)

3803 N. Hargens - N.O. La.
(Address)

(2) Location: SW 1/4, NE 1/4, Sec. 18 T8S R12W
1 miles N. of Pass Christian
(distance) (direction) (Nearest Town)

(3) Topography: flat
(Hilly) (Flat) (Level)

(4) Purpose of Well: domestic
(Domestic Irrigation
Municipal, Industrial, Other)

Description & Color of Materials
Sand, Clay, Red Clay, Shell, etc.

Thick-
ness
Feet

Depth
Feet

<u>sand & mud</u>	<u>36</u>	<u>36</u>
<u>clay</u>	<u>150</u>	<u>186</u>
<u>sand</u>	<u>23</u>	<u>209</u>

Information upon completion of well:

(1) Diameter 2 inches.

(2) Total Depth 209 feet.

(3) Water Level 3 feet below top of ground.

(4) Cased to all, Size 2"

(5) Screen: Size 2", Length 5'


(6) Were any formations sealed against pollution?
no yes, no.

If YES depth of formation _____

Why _____

Drillers Remarks: _____

CODED

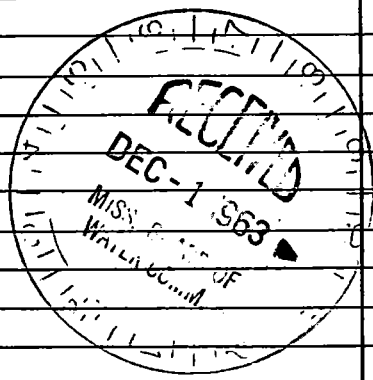

(Use Back Side)

Well No.

1910

John W. ...

...

...

