

CODED

HAR.
0 57
8-30-63

WATER WELL DRILLERS LOG

Date: 8-30, 1963, Driller: Sutter Well Works County Harrison
(Name)

(1) Owner of Land: R. H. Baugh
(Name)
Rt. 1 Box 54A P.C.
(Address)

(2) Location: SW 1/4, NE 1/4, Sec. 10 T85R12W
_____ miles N of Long Beach
(distance) (direction) (Nearest Town)

(3) Topography: flat
(Hilly) (Flat) (Level)

(4) Purpose of Well: domestic
(Domestic Irrigation
Municipal, Industrial, Other)

Description & Color of Materials Sand, Clay, Red Clay, Shell, etc.	Thick- ness Feet	Depth Feet
<u>Sandy Clay</u>	<u>35</u>	<u>35</u>
<u>Clay</u>	<u>10</u>	<u>45</u>
<u>sand</u>	<u>45</u>	<u>90</u>
<u>Clay</u>	<u>26</u>	<u>116</u>
<u>sand</u>	<u>13</u>	<u>129</u>
<u>Clay</u>	<u>81</u>	<u>210</u>
<u>clay - sand streaks</u>	<u>84</u>	<u>294</u>
<u>sand</u>	<u>26</u>	<u>320</u>
<u>Clay</u>	<u>90</u>	<u>410</u>
<u>sand</u>	<u>28</u>	<u>438</u>

Information upon completion of well:

(1) Diameter 2 inches.

(2) Total Depth 438 feet.

(3) Water Level 6 feet below top of ground.

(4) Cased to all, Size 2"


(5) Screen: Size 2", Length 10'

(6) Were any formations sealed against pollution?
_____ yes, no.

If YES depth of formation _____

Why _____

Drillers Remarks: _____

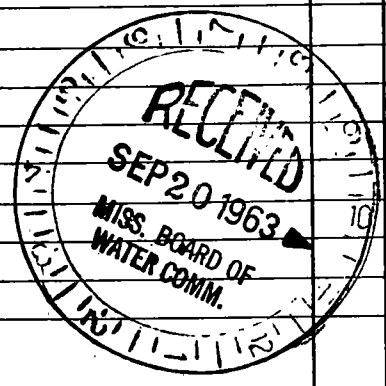

(Use Back Side)

Well No.

1870

1870

