

058

CODED

10-25-63 WATER WELL DRILLERS LOG

Date: 10-25, 19 63, Driller: Lutter Well Works County Harrison  
 (Name)


(1) Owner of Land: Roland Bahan  
 (Name)  
 Rt. 1 Pass Christian  
 (Address)  
 (2) Location: SW 1/4, NE 1/4, Sec. 18 T. 8 S. R. 12 W.  
 1 miles S of Cueva  
 (distance) (direction) (Nearest Town)  
 (3) Topography: flat  
 (Hilly) (Flat) (Level)  
 (4) Purpose of Well: irrigation  
 (Domestic Irrigation, Municipal, Industrial, Other)

Description & Color of Materials Sand, Clay, Red Clay, Shell, etc.	Thick- ness Feet	Depth Feet
Clay	6	6
Sand	39	45

Information upon completion of well:

(1) Diameter 3 inches.  
 (2) Total Depth 45 feet.  
 (3) Water Level 8 feet below top of ground.  
 (4) Cased to all, Size 3"  
 (5) Screen: Size 2", Length 10'  
 (6) Were any formations sealed against pollution?  
 yes,  no,

If YES depth of formation  
 Why  
 Drillers Remarks:

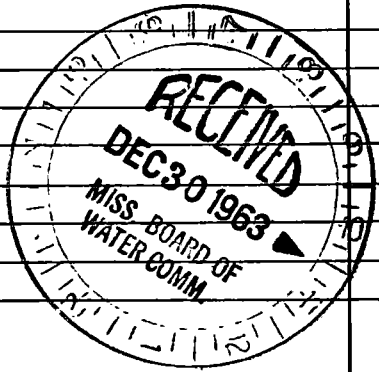

(Use Back Side)

Well No.

Handwritten text at the top of the page, including a date and possibly a name or title.

Second section of handwritten text, appearing to be a list or a series of notes.

Third section of handwritten text, continuing the list or notes.

Fourth section of handwritten text, possibly a concluding paragraph or a signature area.

Fifth section of handwritten text at the bottom of the page.