

CODED

0-60
3-20-64

WATER WELL DRILLERS LOG

Date: 3-20, 1964, Driller: Sutton Well Works County Harrison
(Name)

(1) Owner of Land: Louis Sterita
(Name)
Cuevas, Miss.
(Address)

(2) Location: SW 1/4, SW 1/4, Sec. 23 T8SR 12, W
 miles in of Cuevas
(distance) (direction) (Nearest Town)

(3) Topography: flat
(Hilly) (Flat) (Level)

(4) Purpose of Well: domestic
(Domestic Irrigation
Municipal, Industrial, Other)

Description & Color of Materials Sand, Clay, Red Clay, Shell, etc.	Thick- ness Feet	Depth Feet
<u>Clay</u>	<u>18</u>	<u>18</u>
<u>sand</u>	<u>14</u>	<u>32</u>
<u>Clay</u>	<u>133</u>	<u>165</u>
<u>Rand</u>	<u>27</u>	<u>192</u>
<u>Clay</u>	<u>210</u>	<u>402</u>
<u>sand</u>	<u>38</u>	<u>440</u>

Information upon completion of well:

(1) Diameter 2 inches.

(2) Total Depth 440 feet.

(3) Water Level 2 feet above below top of ground.

(4) Cased to all, Size 2"


(5) Screen: Size 2", Length 10'

(6) Were any formations sealed against pollution?
 yes, ✓ no.

If YES depth of formation

Why

Drillers Remarks:

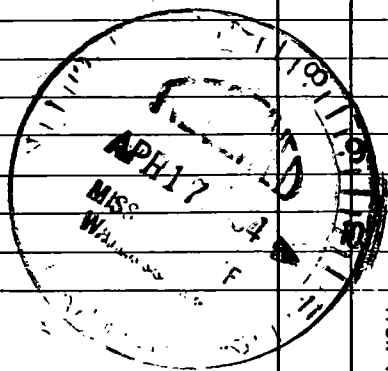

(Use Back Side)

Well No.

Handwritten notes and scribbles, including a large circular mark on the left side of the page. The text is extremely faint and illegible due to heavy noise and low contrast.