

HAR.

0 CA  
5-12-64

WATER WELL DRILLERS LOG

CODED

Date: 5-12, 1964, Driller: Sutton Well Works County Harrison

(Name)

(1) Owner of Land: James Lubrison  
(Name)

Rt 1 - Long Beach, Miss.  
(Address)

(2) Location: NE 1/4, SW 1/4, Sec. 5 T8R12, W

2 miles NE, of Cuevas,  
(distance) (direction) (Nearest Town)

(3) Topography: flat  
(Hilly) (Flat) (Level)

(4) Purpose of Well: domestic  
(Domestic Irrigation  
Municipal, Industrial, Other)

Description & Color of Materials  
Sand, Clay, Red Clay, Shell, etc.

Thick-  
ness  
Feet

Depth  
Feet

Clay

18

18

Sand + gravel

15

33

Clay

324

357

Sand

29

386

Clay

104

490

Sand

56

546

Information upon completion of well:

(1) Diameter 3 inches.

(2) Total Depth 546 feet.

(3) Water Level 5 feet above below top of ground.

(4) Cased to cell, Size 3"

(5) Screen: Size 3", Length 16'


(6) Were any formations sealed against pollution?

no,  yes.

If YES depth of formation \_\_\_\_\_

Why \_\_\_\_\_

Drillers Remarks: \_\_\_\_\_

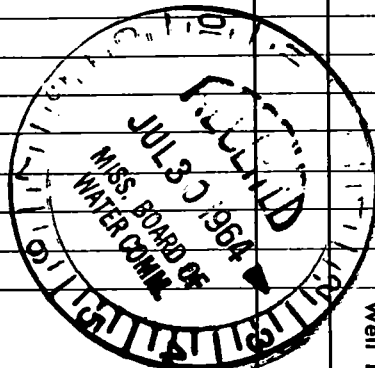

(Use Back Side)

Well No.

1000  
1000  
