

O. W.  
7-16-64

## WATER WELL DRILLERS LOG

Date: 2/16/, 1964, Driller: Sutter Well Works County Harrison  
(Name)

(1) Owner of Land: E. E. Patenette, Jr.  
(Name)  
Cuevas Miss.  
(Address)

(2) Location: NE 1/4, SW 1/4, Sec. 8 T85R12W  
       miles IN, of Cuevas  
(distance) (direction) (Nearest Town)

(3) Topography: Hilly  
(Hilly) (Flat) (Level)

(4) Purpose of Well: Domestic  
(Domestic Irrigation  
Municipal, Industrial, Other)

Description & Color of Materials Sand, Clay, Red Clay, Shell, etc.	Thick- ness Feet	Depth Feet
Clay	16	16
sand	4	20
Clay	390	410
sand	70	480
Clay	84	564
sand	50	614

**Information upon completion of well:**

(1) Diameter 2 inches.

(2) Total Depth 584 feet.

(3) Water Level 4 feet above below top of ground.

(4) Cased to all, Size 2"

(5) Screen: Size 2", Length 16'

(6) Were any formations sealed against pollution?  
       yes,  no.


If YES depth of formation \_\_\_\_\_

Why \_\_\_\_\_

Drillers Remarks: \_\_\_\_\_

\_\_\_\_\_

\_\_\_\_\_

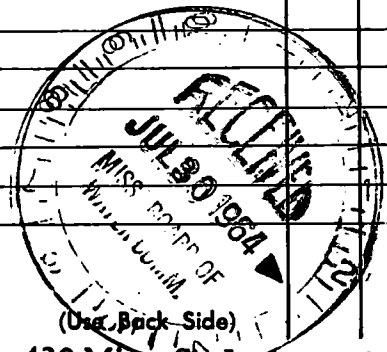

Well No.

Handwritten notes at the top of the page, including a circled number '5' in the upper right corner.

Vertical handwritten notes on the left side of the page, possibly including a list or series of entries.

Handwritten notes on the right side of the page, including a fraction  $\frac{1}{2}$  and other illegible text.

Handwritten notes in the middle section of the page, appearing as a list or series of entries.

Handwritten notes in the lower middle section of the page, including a horizontal line and some numbers.

Extensive handwritten notes at the bottom of the page, including a horizontal line and various illegible text.