

HAR. 069
2-11-65

WATER WELL DRILLERS LOG

CODED

Date: 2-11, 1965, Driller: Sutton Well Works County Harrison
(Name)

(1) Owner of Land: Ernest Davison
(Name)
Long Beach Driss.
(Address)

(2) Location: SE 1/4, SW 1/4, Sec. 15 T8S R12W
1 miles W of Long Beach
(distance) (direction) (Nearest Town)

(3) Topography: flat
(Hilly) (Flat) (Level)


(4) Purpose of Well: domestic
(Domestic Irrigation
Municipal, Industrial, Other)

| Description & Color of Materials Sand, Clay, Red Clay, Shell, etc. | Thick- ness Feet | Depth Feet |
|---|------------------------|---------------|
| <u>sand</u> | <u>30</u> | <u>30</u> |
| <u>clay</u> | <u>75</u> | <u>105</u> |
| <u>clay + sand</u> | <u>65</u> | <u>170</u> |
| <u>sand</u> | <u>58</u> | <u>228</u> |
| <u>clay w/sand streaks</u> | <u>147</u> | <u>375</u> |
| <u>clay</u> | <u>96</u> | <u>471</u> |
| <u>sand</u> | <u>35</u> | <u>506</u> |

Information upon completion of well:

- (1) Diameter 2 inches.
- (2) Total Depth 506 feet.
- (3) Water Level 15 feet below top of ground.
- (4) Cased to all, Size 2"
- (5) Screen: Size 2", Length 10'
- (6) Were any formations sealed against pollution?
_____ yes, _____ no.

If YES depth of formation _____
Why _____
Drillers Remarks: _____

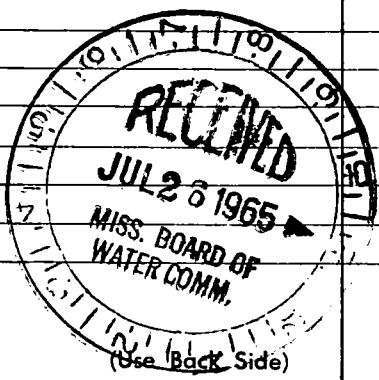

Well No. _____

Handwritten text, possibly a list or ledger, with several columns and rows of entries. The text is very faint and difficult to read, but appears to contain numerical data and descriptive notes.

Approximate structure of the text:

- Top section: Several lines of text, possibly a header or title.
- Middle section: A large block of text, likely a list or ledger, with columns of numbers and descriptive text.
- Bottom section: Additional lines of text, possibly a footer or summary.

Key features:

- Vertical lines suggesting columns.
- Horizontal lines suggesting rows.
- Some text is written in a cursive or slanted style.
- There are some larger, more prominent numbers or words scattered throughout.