

010
2-14-65

WATER WELL DRILLERS LOG

CODED

Date: 2-14, 1965, Driller: Lutter Well Works County Harrison
(Name)

(1) Owner of Land: O. J. Horton
(Name)
Long Beach, Miss.
(Address)

(2) Location: NE 1/4, SW 1/4, Sec. 11 T8R12, W
1 miles N of Long Beach
(distance) (direction) (Nearest Town)

(3) Topography: flat
(Hilly) (Flat) (Level)

(4) Purpose of Well: domestic
(Domestic Irrigation
Municipal, Industrial, Other)

Description & Color of Materials Sand, Clay, Red Clay, Shell, etc.	Thick- ness Feet	Depth Feet
Clay - sand streaks	166	166
fine sand	10	176
Clay	74	250
sand	12	262
Clay	9	271
fine sand	28	299
Clay	36	335
Clay - sand streaks	139	474
sand	24	498

Information upon completion of well:

(1) Diameter 2 inches.

(2) Total Depth 498 feet.

(3) Water Level 2 feet below top of ground.

(4) Cased to all, Size 2"


(5) Screen: Size 2", Length 10'

(6) Were any formations sealed against pollution?
 yes, no.

If YES depth of formation Surface

Why _____

Drillers Remarks: _____

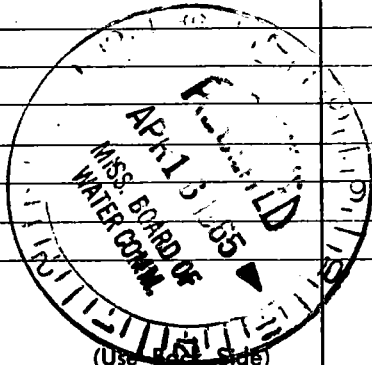

Well No. _____

