

HAR. 1  
0.1  
2-19-65

WATER WELL DRILLERS LOG

CODED

Date: 2-19, 1965, Driller: Sutter Well Works County Harrison  
(Name)

(1) Owner of Land: Bob Ariatti  
(Name)  
25 Park Island Dr. N.O. LA.  
(Address)

(2) Location: NE 1/4, NW 1/4, Sec. 4 T8SR134  
2 miles N of Cumas  
(distance) (direction) (Nearest Town)

(3) Topography: Hilly  
(Hilly) (Flat) (Level)

(4) Purpose of Well: domestic  
(Domestic Irrigation  
Municipal, Industrial, Other)

Description & Color of Materials Sand, Clay, Red Clay, Shell, etc.	Thick- ness Feet	Depth Feet
clay	50	50
clay w/sand streaks	183	233
clay	83	316
sand	18	334
clay w/sand streaks	41	375
sand	30	405
clay	60	465
sand	73	538
sand + gravel	21	559
clay	28	587
sand	145	732

Information upon completion of well:

(1) Diameter 2 inches.

(2) Total Depth 732 feet.

(3) Water Level 10' <sup>above</sup> feet below top of ground.

(4) Cased to cell, Size 2"


(5) Screen: Size 2", Length 15'

(6) Were any formations sealed against pollution?  
yes,  no,

If YES depth of formation \_\_\_\_\_

Why \_\_\_\_\_

Drillers Remarks: \_\_\_\_\_

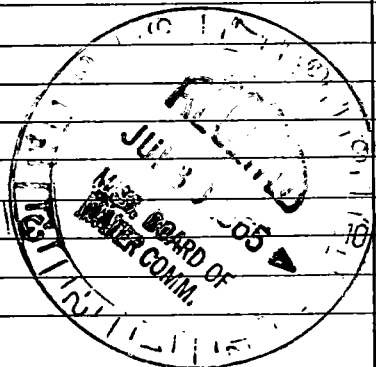

(Use Back Side)

Well No.

Handwritten text, likely bleed-through from the reverse side of the page. The text is extremely faint and illegible due to the quality of the scan and the nature of the bleed-through. It appears to be organized into several columns and rows, possibly representing a list or a set of notes.