

0-75

3-27-65 WATER WELL DRILLERS LOG

CODED

Date: 3-27, 1965, Driller: Sutter Well Works County Harrison

(Name)

(1) Owner of Land: A. J. Ortte
(Name)
Cuevas, Miss.
(Address)

(2) Location: SE 1/4, SW 1/4, Sec. 8 T8SR/24W
1 miles W of Cuevas
(distance) (direction) (Nearest Town)

(3) Topography: Hilly
(Hilly) (Flat) (Level)

(4) Purpose of Well: domestic
(Domestic Irrigation
 Municipal, Industrial, Other)

| Description & Color of Materials Sand, Clay, Red Clay, Shell, etc. | Thick- ness Feet | Depth Feet |
|---|------------------------|---------------|
| <u>Sandy clay</u> | <u>35</u> | <u>35</u> |
| <u>clay</u> | <u>220</u> | <u>255</u> |
| <u>Fine sand w/clay streaks</u> | <u>65</u> | <u>320</u> |
| <u>clay</u> | <u>64</u> | <u>384</u> |
| <u>sand w/clay streaks</u> | <u>22</u> | <u>406</u> |
| <u>sand</u> | <u>25</u> | <u>431</u> |
| <u>clay</u> | <u>2</u> | <u>433</u> |

Information upon completion of well:

(1) Diameter 1 1/2 x 1 1/4 inches.

(2) Total Depth 433 feet.

(3) Water Level 3 feet below top of ground.

(4) Cased to all, Size 1 1/2"

(5) Screen: Size 1/4, Length 10'


(6) Were any formations sealed against pollution?
 _____ yes, _____ no.

If YES depth of formation _____

Why _____

Drillers Remarks: _____

CODED

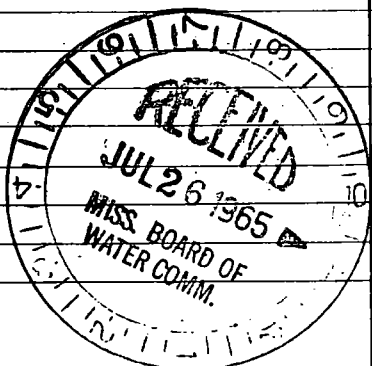

Well No. _____

