

0-14
4-15-65

WATER WELL DRILLERS LOG

CODED

Date: 4-15, 19 65, Driller: Sutton Well Works County Harrison
(Name)

(1) Owner of Land: Edu. A. Dinkelayish
(Name)
Cuevas, Miss.
(Address)

(2) Location: SW 1/4, NE 1/4, Sec. 7 T8SR12W
1 miles W of Cuevas,
(distance) (direction) (Nearest Town)

(3) Topography: flat
(Hilly) (Flat) (Level)

(4) Purpose of Well: domestic
(Domestic Irrigation
Municipal, Industrial, Other)

Description & Color of Materials Sand, Clay, Red Clay, Shell, etc.	Thick- ness Feet	Depth Feet
<u>sandy clay</u>	<u>40</u>	<u>40</u>
<u>sand w/clay streaks</u>	<u>23</u>	<u>63</u>
<u>clay</u>	<u>63</u>	<u>126</u>
<u>sand</u>	<u>29</u>	<u>155</u>
<u>clay w/sand streaks</u>	<u>57</u>	<u>212</u>
<u>sand</u>	<u>24</u>	<u>236</u>
<u>clay w/sand streaks</u>	<u>111</u>	<u>347</u>
<u>sand</u>	<u>59</u>	<u>406</u>
<u>clay</u>	<u>69</u>	<u>475</u>
<u>clay w/sand streaks</u>	<u>82</u>	<u>557</u>
<u>sand</u>	<u>47</u>	<u>604</u>

Information upon completion of well:

(1) Diameter 2 inches.

(2) Total Depth 604 feet.

(3) Water Level 15 feet above below top of ground.

(4) Cased to all, Size 2"


(5) Screen: Size 2", Length 15'

(6) Were any formations sealed against pollution?
_____ yes, no.

If YES depth of formation _____

Why _____

Drillers Remarks: _____

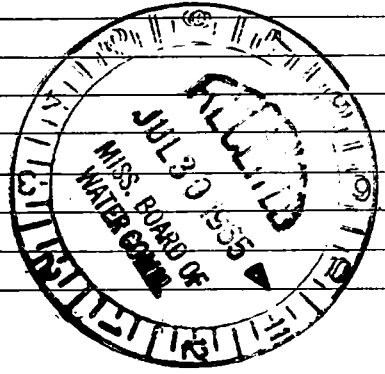

(Use Back Side)

Well No.

Handwritten text at the top of the page, possibly a title or header, which is mostly illegible due to fading and noise.

Main body of handwritten text, appearing to be a list or series of entries. The text is very faint and difficult to decipher, but some words like "No. 1" and "No. 2" are visible.

Handwritten text in the lower middle section of the page, continuing the list or entries. Some lines are underlined.

Handwritten text at the bottom of the page, possibly a conclusion or signature area. The text is very faint and illegible.