

HAR.
0 15
4-19-65

WATER WELL DRILLERS LOG

CODED

Date: 4-19-65, 19___, Driller: Sutter Wheel Works County Harrison
(Name)

(1) Owner of Land: W. W. Davis
(Name)
Box 54 - Cuevas, Miss
(Address)

(2) Location: NE 1/4, SW 1/4, Sec. 5 T8SR12W
1 miles N of Cuevas,
(distance) (direction) (Nearest Town)

(3) Topography: flat
(Hilly) (Flat) (Level)

(4) Purpose of Well: Domestic
(Domestic Irrigation
Municipal, Industrial, Other)

Description & Color of Materials Sand, Clay, Red Clay, Shell, etc.	Thick- ness Feet	Depth Feet
<u>clay</u>	<u>20</u>	<u>20</u>
<u>Sand</u>	<u>32</u>	<u>52</u>
<u>Clay with sand streaks</u>	<u>133</u>	<u>185</u>
<u>Sand</u>	<u>22</u>	<u>207</u>
<u>Clay</u>	<u>17</u>	<u>224</u>
<u>Sand</u>	<u>22</u>	<u>246</u>

Information upon completion of well:

(1) Diameter 2 inches.

(2) Total Depth 246 feet.

(3) Water Level 1/2 above feet below top of ground.


(4) Cased to cell, Size 2"

(5) Screen: Size 2", Length 5'

(6) Were any formations sealed against pollution?
_____ yes, no.

If YES depth of formation _____
Why _____

Drillers Remarks: _____

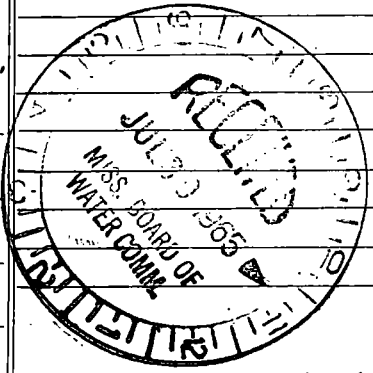

(Use Back Side)

Well No.

Handwritten notes and text, possibly a list or index, located in the upper left and center of the page. The text is faint and difficult to read.

Handwritten notes and text, possibly a list or index, located in the lower right quadrant of the page. The text is faint and difficult to read.