

HAR. MISSISSIPPI BOARD OF WATER COMMISSIONERS

071
4-30-65

WATER WELL DRILLERS LOG

CODED

Date: ~~4-30~~ 4-30, 1965, Driller: Intec Well Works County Harrison
(Name)

(1) Owner of Land: Henry Chinishe
(Name)
Long Beach, Miss.
(Address)

(2) Location: SW 1/4, SE 1/4, Sec. 28 T85R12W
2 miles N of Long Beach
(distance) (direction) (Nearest Town)

(3) Topography: flat
(Hilly) (Flat) (Level)

(4) Purpose of Well: domestic
(Domestic Irrigation
Municipal, Industrial, Other)

Description & Color of Materials Sand, Clay, Red Clay, Shell, etc.	Thick- ness Feet	Depth Feet
<u>sand</u>	<u>23</u>	<u>23</u>
<u>clay</u>	<u>22</u>	<u>45</u>
<u>sand</u>	<u>8</u>	<u>53</u>
<u>clay</u>	<u>327</u>	<u>380</u>
<u>sand</u>	<u>34</u>	<u>414</u>
<u>clay</u>	<u>244</u>	<u>658</u>
<u>sand</u>	<u>60</u>	<u>718</u>

Information upon completion of well:

(1) Diameter 2 x 2 1/2 inches.

(2) Total Depth 718 feet.

(3) Water Level 4 feet below top of ground.

(4) Cased to all, Size 2 1/2"

(5) Screen: Size 2", Length 30'


(6) Were any formations sealed against pollution?
_____ yes, no.

CODED

If YES depth of formation _____

Why _____

Drillers Remarks: _____

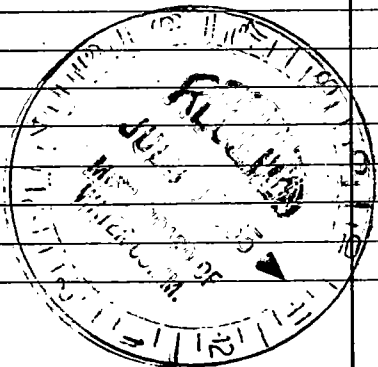

(Use Back Side)

Well No.

Account of the ...

1820
1821
1822
1823
1824
1825

...
...
