

CODED

5-27-65

WATER WELL DRILLERS LOG

Date: 5-27, 1965, Driller: Butler Well Works County Harrison

(Name)

(1) Owner of Land: Jim Martin
(Name)
22 1/2 Pass Road, Gulfport
(Address)

(2) Location: SW 1/4, NE 1/4, Sec. 6 T8SR12W
1 miles N of Cuevas
(distance) (direction) (Nearest Town)

(3) Topography: hilly
(Hilly) (Flat) (Level)

(4) Purpose of Well: domestic
(Domestic Irrigation
Municipal, Industrial, Other)

Description & Color of Materials Sand, Clay, Red Clay, Shell, etc.	Thick- ness Feet	Depth Feet
Clay	117	117
sand	21	138
Clay	90	228
sand	12	240
Clay	130	370
sand	18	388
Clay	85	473
sand	11	484
Clay	5	489
sand	42	531

Information upon completion of well:


- (1) Diameter 2 1/2 inches.
- (2) Total Depth 531 feet.
- (3) Water Level 9 feet above below top of ground.
- (4) Cased to all, Size 2 1/2"
- (5) Screen: Size 2 1/2", Length 10'
- (6) Were any formations sealed against pollution?
no

If YES depth of formation _____

Why _____

Drillers Remarks: _____

CODED

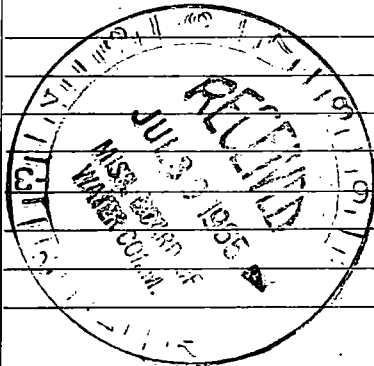

(Use Back Side)

Well No.

Handwritten header text, possibly a title or date, located at the top of the page.

Main body of handwritten text, appearing to be a list or series of entries, possibly including names and dates.

Lower section of handwritten text, possibly a continuation of the list or a separate set of notes.