

HAR. MISSISSIPPI BOARD OF WATER COMMISSIONERS

085

10-25-65

WATER WELL DRILLERS LOG CODED

Date: 10-25, 1965, Driller: Antler Well Works County Harrison

(Name)

(1) Owner of Land: Cora Difford
(Name)

Rt Bot 146-c Long Beach, Miss
(Address)

(2) Location: SW 1/4, NE 1/4, Sec. 10 T8S R12E
1 miles N of Long Beach
(distance) (direction) (Nearest Town)

(3) Topography: flat
(Hilly) (Flat) (Level)

(4) Purpose of Well: domestic
(Domestic Irrigation
Municipal, Industrial, Other)

Description & Color of Materials Sand, Clay, Red Clay, Shell, etc.	Thick- ness Feet	Depth Feet
<u>Random clay</u>	<u>47</u>	<u>47</u>
<u>clay</u>	<u>18</u>	<u>65</u>
<u>clay - sand streaks</u>	<u>236</u>	<u>301</u>
<u>clay</u>	<u>167</u>	<u>468</u>
<u>sand</u>	<u>18</u>	<u>486</u>

Information upon completion of well:


- (1) Diameter 2 inches.
- (2) Total Depth 486 feet.
- (3) Water Level 6 feet below top of ground.
- (4) Cased to all, Size 2"
- (5) Screen: Size 2", Length 10'
- (6) Were any formations sealed against pollution?
no

If YES depth of formation _____

Why _____

Drillers Remarks: _____

CODED

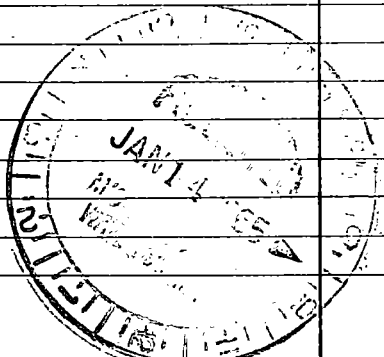

(Use Back Side)

Well No. _____

1880

1880

