

HAR. MISSISSIPPI BOARD OF WATER COMMISSIONERS

O 9A
11-1-65

WATER WELL DRILLERS LOG

CODED

Date: 11-1, 1965, Driller: Little Well Works County Harrison
(Name)

	Description & Color of Materials Sand, Clay, Red Clay, Shell, etc.	Thick- ness Feet	Depth Feet
(1) Owner of Land: <u>Scarborough Realty</u> (Name) <u>Long Beach, Miss.</u> (Address)	<u>Clay - sand streak</u>	<u>169</u>	<u>169</u>
(2) Location: <u>NW 1/4, SE 1/4, Sec. 11 T85 R12W</u> <u>1</u> miles <u>N</u> , of <u>Long Beach</u> (distance) (direction) (Nearest Town)	<u>Clay</u>	<u>302</u>	<u>471</u>
(3) Topography: <u>flat</u> (Hilly) (Flat) (Level)	<u>sand</u>	<u>28</u>	<u>499</u>
(4) Purpose of Well: <u>domestic</u> (Domestic Irrigation Municipal, Industrial, Other)			


Information upon completion of well:

- (1) Diameter 2 inches.
- (2) Total Depth 499 feet.
- (3) Water Level 5 feet below top of ground.
- (4) Cased to cell, Size 2"
- (5) Screen: Size 2", Length 10'
- (6) Were any formations sealed against pollution?
 yes, no.

If YES depth of formation surface

Why _____

Drillers Remarks: _____

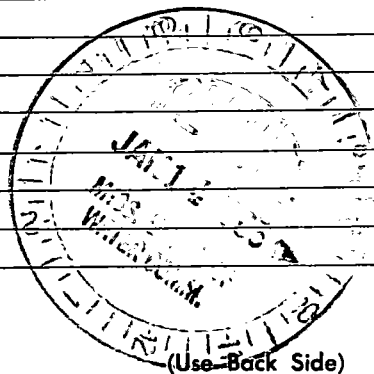

(Use Back Side)

Well No.

[Faint, illegible handwritten text, possibly bleed-through from the reverse side of the page.]