

HAR.

MISSISSIPPI BOARD OF WATER COMMISSIONERS

O 85  
11-30-65

WATER WELL DRILLERS LOG

CODED

Date: 11-30, 1965, Driller: Sutton Well Works County Harrison  
(Name)

(1) Owner of Land: Richard Clay  
(Name)  
819 Upperline St., New Orleans  
(Address) La.

(2) Location: SE 1/4, SE 1/4, Sec. 7 T85R12W  
1 miles S of Cuevas  
(distance) (direction) (Nearest Town)

(3) Topography: flat  
(Hilly) (Flat) (Level)

(4) Purpose of Well: domestic  
(Domestic Irrigation  
Municipal, Industrial, Other)

Description & Color of Materials Sand, Clay, Red Clay, Shell, etc.	Thick- ness Feet	Depth Feet
<u>Clay - sand streaks</u>	<u>27</u>	<u>27</u>
<u>Clay</u>	<u>57</u>	<u>134</u>
<u>sand</u>	<u>18</u>	<u>152</u>
<u>Clay - fine sand st.</u>	<u>248</u>	<u>400</u>
<u>sand</u>	<u>37</u>	<u>437</u>


Information upon completion of well:

- (1) Diameter 2 inches.
- (2) Total Depth 437 feet.
- (3) Water Level 2 feet above below top of ground.
- (4) Cased to all, Size 2"
- (5) Screen: Size 2", Length 10'
- (6) Were any formations sealed against pollution?  
 yes,  no.

If YES depth of formation Surface

Why \_\_\_\_\_

Drillers Remarks: \_\_\_\_\_

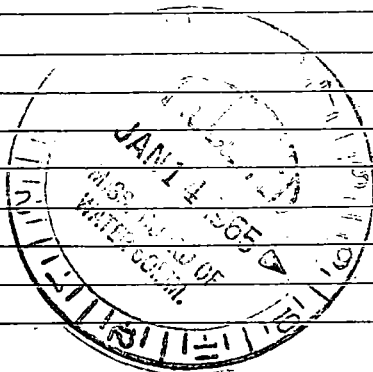

(Use Back Side)

Well No.

Handwritten text at the top of the page, possibly a title or header.

Handwritten notes on the left side of the page, including some numbers and symbols.

Handwritten text in the upper middle section of the page.

Handwritten text in the middle right section of the page.

Handwritten text in the lower right section of the page, possibly a list or table.

Handwritten text at the bottom of the page, possibly a signature or footer.

