

HAR.

Odf
4-16-66

MISSISSIPPI BOARD OF WATER COMMISSIONERS

WATER WELL DRILLERS LOG

CODED

Date: 4-16, 1966, Driller: Sutter Well Works County Harrison
(When well drilled) (Name) (Where well is located)

(1) Owner of Land: Poland Bahaw
(Name)
Rt. 1 Pass Christian
(Address)

(2) Location NW 1/4, SE 1/4, Sec. 7 T85R12, W
1 miles W of Cuevas
(distance) (direction) (Nearest Town)

(3) Topography: Hilly
(Hilly) (Flat) (Level)

(4) Purpose of Well: domestic
(Domestic Irrigation
Municipal, Industrial, Other)

Description & Color of Materials Sand, Clay, Red Clay, Shell, etc.	Thick- ness Feet	Depth Feet
old well	100	100
Clay	65	165
Sand	7	172
Clay	18	190
Sand	8	198
Clay	68	266
sand	12	278

Information upon completion of well:

(1) Diameter 2 inches.

(2) Total Depth 278 feet.

(3) Water Level 1 feet above below top of ground.

(4) Cased to all, Size 2"

(5) Screen: Size 2', Length 10'

(6) Were any formations sealed against pollution?
no yes, no.

CODED

If YES depth of formation _____


Why _____

Drillers Remarks: _____

Yield in gpm: 20

Size pump: not furnished

Type power: _____

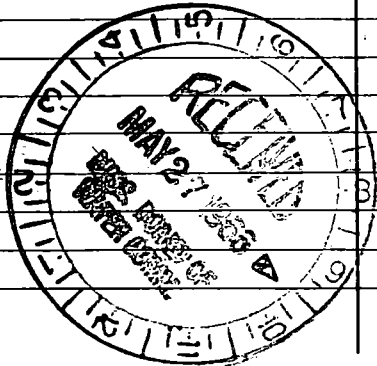

Handwritten notes at the top of the page, including the number "4" and some illegible text.

Main body of handwritten text, appearing to be a list or series of entries, with some numbers and words that are difficult to decipher due to the image quality.

Continuation of handwritten text, showing more entries and possibly some calculations or measurements.

Bottom section of handwritten text, including a large, faint circular stamp or seal on the left side.