

HAR. 092
5-12-66

MISSISSIPPI BOARD OF WATER COMMISSIONERS **CODED**

WATER WELL DRILLERS LOG

Date: 5-12, 1966, Driller: Luther Well Wash County Harrison
(When well drilled) (Name) (Where well is located)

(1) Owner of Land: Henry Schmidt
(Name)

Chevas Miss.
(Address)

(2) Location: NW ¼, SW ¼, Sec. 7 T8S R12, W

1 miles W, of Chevas
(distance) (direction) (Nearest Town)

(3) Topography: flat
(Hilly) (Flat) (Level)


(4) Purpose of Well: domestic
(Domestic Irrigation, Municipal, Industrial, Other)

Description & Color of Materials Sand, Clay, Red Clay, Shell, etc.	Thick- ness Feet	Depth Feet
Clay	18	18
Sand - gravel	27	45
Clay	168	213
Sand	27	240

Information upon completion of well:

(1) Diameter 1 1/2 inches.
(2) Total Depth 240 feet.
(3) Water Level 1 feet above top of ground.
(4) Cased to all, Size 1 1/2"
(5) Screen: Size 1 1/2", Length 5'
(6) Were any formations sealed against pollution?
_____ yes, no.

If YES depth of formation _____
Why _____
Drillers Remarks: _____
Yield in gpm: 14
Size pump: not furnished
Type power: _____

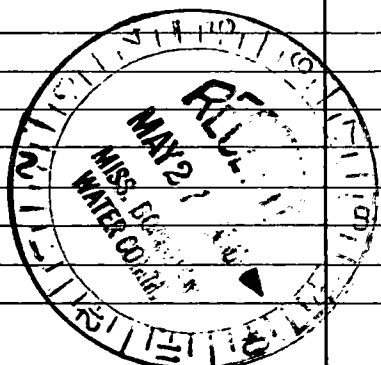

[Faint, illegible handwritten text, possibly bleed-through from the reverse side of the page.]