

Harrison  
 OPA  
 10-66

MISSISSIPPI BOARD OF WATER COMMISSIONERS

60D

WATER WELL DRILLERS LOG

Date: 10-27, 1966, Driller: Sutter Well Wks. County Harrison  
 (When well drilled) (Name) (Where well is located)

(1) Owner of Land: Long Spata  
 (Name)  
Long Beach Miss  
 (Address)  
 (2) Location: NE 1/4, SW 1/4, Sec. 3 T8SR 12, W  
2 miles N of Long Beach  
 (distance) (direction) (Nearest Town)  
 (3) Topography: flat  
 (Hilly) (Flat) (Level)  
 (4) Purpose of Well: domestic  
 (Domestic Irrigation  
 Municipal, Industrial, Other)

Description & Color of Materials Sand, Clay, Red Clay, Shell, etc.	Thick- ness Feet	Depth Feet
Surface Sand	30	30
Clay	338	368
fine Sand	12	380
Clay	46	426
Sand	25	451

CODED

Information upon completion of well:

(1) Diameter 2 inches.  
 (2) Total Depth 451 feet.  
 (3) Water Level 1 feet above below top of ground.  
 (4) Cased to all, Size 2"  
 (5) Screen: Size 2", Length 10'  
 (6) Were any formations sealed against pollution?  
 \_\_\_\_\_ yes,  no.

If YES depth of formation \_\_\_\_\_


Why \_\_\_\_\_

Drillers Remarks: \_\_\_\_\_

Yield in gpm: 15

Size pump: 1/2

Type power: elec.

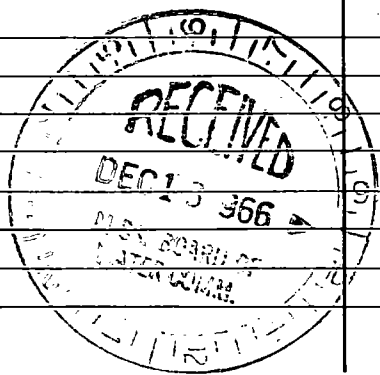

*[Faint, illegible handwriting throughout the page, possibly bleed-through from the reverse side.]*