

**MISSISSIPPI
BOARD OF WATER COMMISSIONERS**
416 North State Street
Jackson, Mississippi 39201

CODED

WATER WELL DRILLERS LOG

date well completed 1-30 1967 firm name Switzer Shell Co. county well located Harrison

LANDOWNER: Jack Randall

description of formations encountered

from to

| | | | |
|--|----------------------------|------------|------------|
| <u>Pineville Rd, 3 blks N.</u> | <u>mixed sand</u> | <u>0</u> | <u>24</u> |
| | <u>sand</u> | <u>24</u> | <u>34</u> |
| <u>Klondike Intersections Long Beach</u> | <u>clay + sand (stake)</u> | <u>34</u> | <u>135</u> |
| (mailing address) | <u>clay + sand (stake)</u> | <u>135</u> | <u>156</u> |
| | <u>clay</u> | <u>156</u> | <u>198</u> |
| | <u>mixed</u> | <u>198</u> | <u>210</u> |
| | <u>clay</u> | <u>210</u> | <u>241</u> |
| | <u>mixed</u> | <u>241</u> | <u>256</u> |
| | <u>clay</u> | <u>256</u> | <u>285</u> |
| | <u>soft clay</u> | <u>285</u> | <u>307</u> |
| | <u>clay</u> | <u>307</u> | <u>437</u> |
| | <u>fine sand</u> | <u>437</u> | <u>483</u> |
| | <u>good sand</u> | <u>483</u> | <u>505</u> |

WELL LOCATION:

sec. 11 T. 8 S. R. 12 W.
1 miles N of LONG BEACH
(distance) (direction) (nearest town)

WELL PURPOSE: Home
(home, irrigation, municipal, industrial)


WELL COMPLETION DATA:

- diameter (inches) 2
- total depth (feet) 506
- static water level (feet) 4 below top of ground.
- casing gal. steel, 496'
(material) (depth)
2" If telescope see back.
(size)
- screen 10', 496'
(length) (depth to top)
2", 8ga ss on pipe
(size) (material)
- pump 3/4, 14
(HP) (yield gpm)
electric
(type power)
- electric log No
(yes or no)

(organization running log)


(8) how well bottom plugged back
pressure valve

DRILLERS REMARKS:

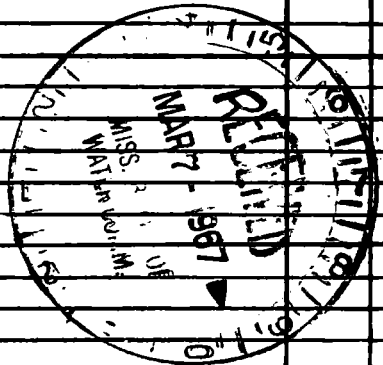

If well telescopes please sketch and show depths.

GROUND LEVEL

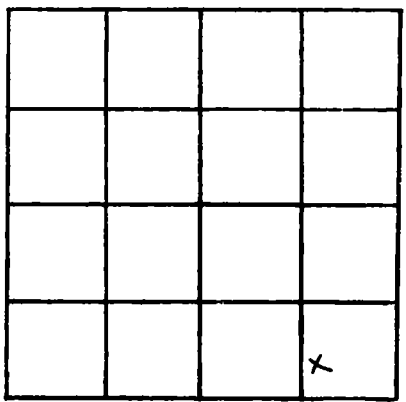

SECTION 11

Please indicate well location X.

ADDITIONAL INFORMATION

If more than one screen, show locations of each on sketch.