

**MISSISSIPPI
BOARD OF WATER COMMISSIONERS**
416 North State Street
Jackson, Mississippi 39201

WATER WELL DRILLERS LOG

CODED

Harrison
0105
4-67

4-10 1967 Letter Well Works Harrison
date well completed firm name county well located

LANDOWNER: Agnes M. Miesinger

description of formations encountered	from	to

Box 352

Pass Christian, Miss.
(mailing address)

WELL LOCATION:


sec. 18 T. 8 N. R. 12 E. S. 5 W. Pass Christian
(distance) (direction) (nearest town)

WELL PURPOSE: home
(home, irrigation, municipal, industrial)

WELL COMPLETION DATA:


- (1) diameter (inches) 2
- (2) total depth (feet) 236
- (3) static water level (feet) 17 below above-top of ground.
- (4) casing galv. 231'
(material) (depth)
(size) if telescope see back.
- (5) screen 5' 231'
(length) (depth to top)
2" stainless steel
(size) (material)
- (6) pump unknown
(HP) (yield gpm)
(type power)
- (7) electric log no
(yes or no)
(organization running log)
- (8) how well bottom plugged B.P. Value

DRILLERS REMARKS:

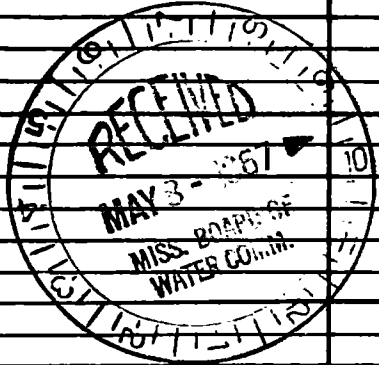

If well telescopes please sketch and show depths.

GROUND LEVEL

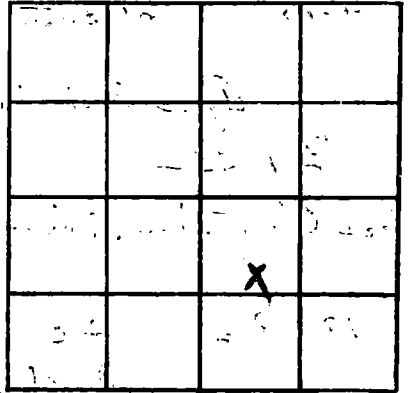

SECTION 18

Please indicate well location X.

ADDITIONAL INFORMATION

Lined area for additional information.

If more than one screen, show locations of each on sketch.