

Harrison  
 0106  
 4-67

MISSISSIPPI  
 BOARD OF WATER COMMISSIONERS  
 416 North State Street  
 Jackson, Mississippi 39201

CODED

WATER WELL DRILLERS LOG

4-24 1967 Sutter Well Works Harrison  
 date well completed firm name county well located

LANDOWNER LATHANIA D WEN

Long Beach  
 Miss.

(mailing address)

description of formations encountered

from to

Clay	0	10
Sand	10	38
Clay	38	200
Sand	200	229

WELL LOCATION:


sec. 10 T 8 N R 12 E  
 S  
 1 miles N of Long Beach  
 (distance) (direction) (nearest town)

WELL PURPOSE: home  
 (home, irrigation, municipal, industrial)

CODED

WELL COMPLETION DATA:

- (1) diameter (inches) 2
- (2) total depth (feet) 229
- (3) static water level (feet) 6 below top of ground
- (4) casing galv. 219' (material) (depth)
- 2" (size) if telescope see back.
- (5) screen 10' 219' (length) (depth to top)
- 2" stainless steel (size) (material)
- (6) pump unknown (HP) (yield gpm)
- (type power)
- (7) electric log No (yes or no)
- (organization running log)
- (8) how well bottom plugged BP Valve

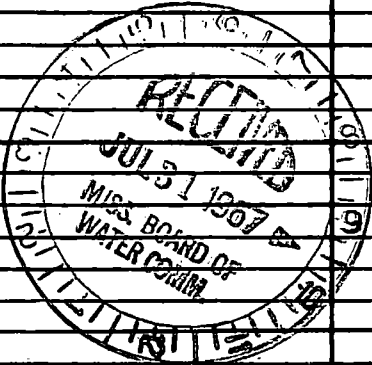

DRILLERS REMARKS:

If well telescopes please sketch and show depths.

GROUND LEVEL

X			

SECTION 10

Please indicate well location X.

ADDITIONAL INFORMATION

If more than one screen, show locations of each on sketch.