

Harrison  
 0161  
 5-67

MISSISSIPPI  
 BOARD OF WATER COMMISSIONERS  
 416 North State Street  
 Jackson, Mississippi 39201

**CODED**

WATER WELL DRILLERS LOG

5-18 1967 Sutter Well Works Harrison  
 date well completed firm name county well located

LANDOWNER: J B Harris  
Cuevas,  
Miss  
 (mailing address)

description of formations encountered	from	to
<u>sand</u>	<u>0</u>	<u>15</u>
<u>clay</u>	<u>15</u>	<u>186</u>
<u>sand</u>	<u>186</u>	<u>236</u>

WELL LOCATION:  
 sec. 5 T 8 S R. 12 E W  
1 miles E of Cuevas  
 (distance) (direction) (nearest town)

WELL PURPOSE: home  
 (home, irrigation, municipal, industrial)

WELL COMPLETION DATA:

- (1) diameter (inches) 2
- (2) total depth (feet) 236
- (3) static water level (feet) 10 below above top of ground.
- (4) casing galv. 231'  
 (material) (depth)
- 2"  
 (size) If telescope see back.
- (5) screen 5' 231'  
 (length) (depth to top)
- 2" stainless steel  
 (size) (material)
- (6) pump 1/3 6  
 (HP) (yield gpm)
- elec.  
 (type power)
- (7) electric log no  
 (yes or no)

(organization running log)


(8) how well bottom plugged BP Value

DRILLERS REMARKS:



If well telescopes please sketch and show depths.

GROUND LEVEL

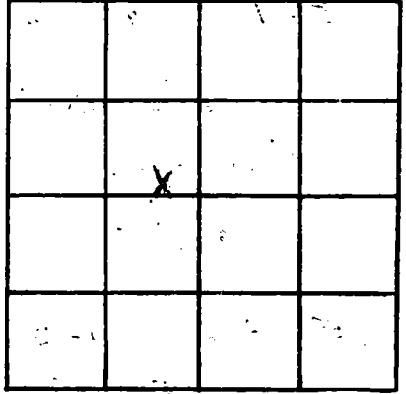

SECTION 5

Please indicate well location X.

**ADDITIONAL INFORMATION**

If more than one screen, show locations of each on sketch.