

Harrison  
0109  
7-67

MISSISSIPPI  
 BOARD OF WATER COMMISSIONERS  
 416 North State Street  
 Jackson, Mississippi 39201

**CODED**

WATER WELL DRILLERS LOG

7-26 1967 Sutter Well Works Harrison  
 date well completed firm name county well located

LANDOWNER: Buy Allen  
Long Beach  
Miss.  
 (mailing address)

description of formations encountered	from	to
<u>Sand &amp; gravel</u>	<u>0</u>	<u>136</u>
<u>Clay - sand streak</u>	<u>136</u>	<u>430</u>
<u>Sand</u>	<u>430</u>	<u>465</u>

WELL LOCATION:  
 sec. 10 T 8 S R. 12 W  
1 miles NW of Long Beach  
 (distance) (direction) (nearest town)

WELL PURPOSE: home  
 (home, irrigation, municipal, industrial)

WELL COMPLETION DATA:

- diameter (inches) 2
- total depth (feet) 465
- static water level (feet) 2 ~~below~~ above top of ground.
- casing galv. 455'  
 (material) (depth)  
2" If telescope see back.  
 (size)
- screen 10' 455'  
 (length) (depth to top)  
2" stainless steel  
 (size) (material)
- pump 1/2 15  
 (HP) (yield gpm)  
elec.  
 (type power)
- electric log no  
 (yes or no)  
 (organization running log)
- how well bottom plugged B.P. Value


**PAID**



DRILLERS REMARKS:

If well telescopes please sketch and show depths.

GROUND LEVEL

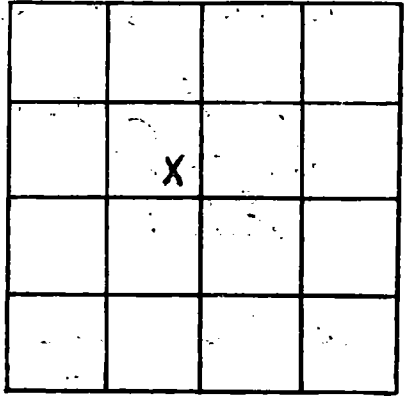

SECTION 10

Please indicate well location X.

ADDITIONAL INFORMATION

If more than one screen, show locations of each on sketch.