

HARRISON
 O 110
 7-67

MISSISSIPPI
 BOARD OF WATER COMMISSIONERS
 416 North State Street
 Jackson, Mississippi 39201

CODED

WATER WELL DRILLERS LOG

7-24 1967 Sutton Well Works Harrison
 date well completed firm name county well located

LANDOWNER:	Description of formations encountered	from	to
<u>Jack Blackwell</u>	<u>Clay</u>	<u>0</u>	<u>30</u>
<u>Long Beach</u>	<u>Sand</u>	<u>30</u>	<u>58</u>
<u>Miss</u>	<u>Clay</u>	<u>58</u>	<u>187</u>
(mailing address)	<u>Sand</u>	<u>187</u>	<u>193</u>
WELL LOCATION:	<u>Clay</u>	<u>193</u>	<u>200</u>
sec. <u>7</u> T. <u>8</u> S. R. <u>12</u> E. W. <u>W</u>	<u>Sand</u>	<u>200</u>	<u>215</u>
<u>1</u> miles <u>N</u> of <u>Pass Christian</u>	<u>Clay</u>	<u>215</u>	<u>221</u>
(distance) (direction) (nearest town)			

CODED

WELL PURPOSE: home
 (home, irrigation, municipal, industrial)


WELL COMPLETION DATA:

- (1) diameter (inches) 2
- (2) total depth (feet) 221
- (3) static water level (feet) 2 below above top of ground.
- (4) casing Galv. (material), 216' (depth)
- 2" (size) if telescope see back.
- (5) screen 5' (length), 216' (depth to top)
- 2" (size), Stainless Steel (material)
- (6) pump 1/2 (HP), 10 (yield gpm)
- elc (type power)
- (7) electric log no (yes or no)

(organization running log)

(8) how well bottom plugged B.P. Valve

DRILLERS REMARKS: 13' blank pipe below screen

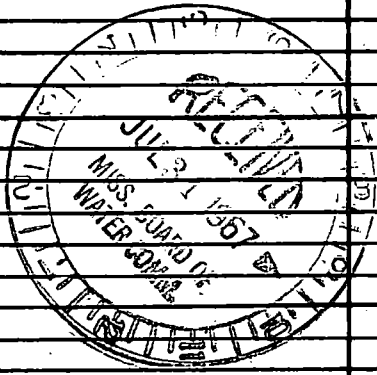

If well telescopes please sketch and show depths.

GROUND LEVEL

203' of 2" galv.

5' of Stainless Steel Strainer

13' of 2" galv.



		X	

SECTION 7

Please indicate well location X.

ADDITIONAL INFORMATION

If more than one screen, show locations of each on sketch.