

Harrison
 0112
 8-67

MISSISSIPPI
 BOARD OF WATER COMMISSIONERS
 416 North State Street
 Jackson, Mississippi 39201

CODED

WATER WELL DRILLERS LOG

Hug 1967 M+B Drilling Co. Harrison
 date well completed firm name county well located

LANDOWNER: Henry Stephens
 Cates Ave SHELPHENS
 Long Beach, Miss.
 (mailing address)

WELL LOCATION:
 sec. 12 T 8 S R. 12 W
 1 miles N of Long Beach
 (distance) (direction) (nearest town)


WELL PURPOSE: Home
 (home, irrigation, municipal, industrial)

WELL COMPLETION DATA:

- (1) diameter (inches) 2
 - (2) total depth (feet) 440
 - (3) static water level (feet) 3 below
 top of ground.
 - (4) casing Galv. Steel 4 3/8
 (material) (depth)
 2" (size) if telescope see back.
 - (5) screen 10ft 430
 (length) (depth to top)
 2" Staircase Steel-7 slot
 (size) (material)
 - (6) pump 1 15
 (HP) (yield gpm)
 270V 1φ
 (type power)
 - (7) electric log No
 (yes or no)
- (organization running log)
- (8) how well bottom plugged
 Brass Back Wash Valve

description of formations encountered	from to	
Top Sand	0	20
Clay Clay	20	28
Sea Shells + Sand	28	31
Grey Clay	31	67
Blue Clay	67	130
Grey Clay	130	150
Sand	150	155
Blue Clay	155	182
Fine Sand	182	189
Blue Clay	189	327
Fine Sand	327	335
Blue Clay	335	425
Sand	425	440

LOGGED

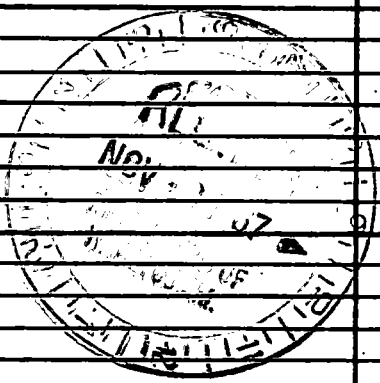

DRILLERS REMARKS:

If well telescopes please sketch and show depths.

GROUND LEVEL

Ground Level

	X		

SECTION 12

Please indicate well location X.

ADDITIONAL INFORMATION

If more than one screen, show locations of each on sketch.