

Harrison
 O 115
 10-67

MISSISSIPPI
 BOARD OF WATER COMMISSIONERS
 416 North State Street
 Jackson, Mississippi 39201

CODED

WATER WELL DRILLERS LOG

10-25 1967 date well completed
 Sutter Well Works firm name
 Harrison county well located

LANDOWNER: H.F. Platts

description of formations encountered

from

to

Box 127

Long Beach, Miss.
 (mailing address)

sand-clay streak
clay
sand

0 109
109 395
395 417

WELL LOCATION:

sec. 11 T 8 R S R 12 E
2 miles N of Long Beach
 (distance) (direction) (nearest town)

WELL PURPOSE: home
 (home, irrigation, municipal, industrial)

WELL COMPLETION DATA:

(1) diameter (inches) 2

(2) total depth (feet) 417

(3) static water level (feet) 1 ^{below} above top of ground.

(4) casing galv. 407'
 (material) (depth)

2" If telescope see back.
 (size)

(5) screen 10' 407'
 (length) (depth to top)

2" stainless steel
 (size) (material)

(6) pump 1 15
 (HP) (yield gpm)


elec
 (type power)

(7) electric log no
 (yes or no)

(organization running log)

(8) how well bottom plugged BeP Valve

CODED

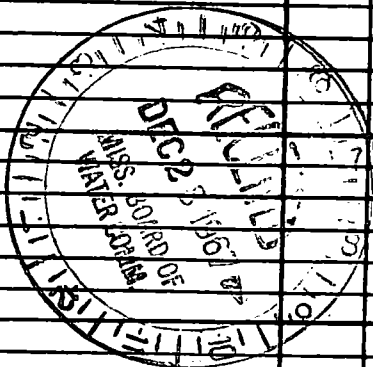

DRILLERS REMARKS:

