

CODED

MISSISSIPPI
BOARD OF WATER COMMISSIONERS
416 North State Street
Jackson, Mississippi 39201

WATER WELL DRILLERS LOG

Harrison
0116
11-67

Nov. 3 1967 M+B Drilling Co. Harrison
date well completed firm name county well located

LANDOWNER: William Workack
Espy Ave,
Pass Christian, Miss.
(mailing address)


WELL LOCATION:
sec. 9 T. 8 S R. 12 W
2 miles W of Long Beach
(distance) (direction) (nearest town)

WELL PURPOSE: Home
(home, irrigation, municipal, industrial)

- WELL COMPLETION DATA:
- (1) diameter (inches) 2
 - (2) total depth (feet) 475
 - (3) static water level (feet) 6 below top of ground.
 - (4) casing Galvanized Steel 435
(material) (depth)
2" if telescope see back.
(size)
 - (5) screen 10 ft. 435
(length) (depth to top)
2" - 010, Stainless Steel Underbar
(size) (material)
 - (6) pump 1 15
(HP) (yield gpm)
110 V 1Ø
(type power)
 - (7) electric log No
(yes or no)

(organization running log)
 - (8) how well bottom plugged 2"
Backwash Valve


description of formations encountered	from	to
	0	2
Surface	0	2
Sand	2	32
Grey Sand	32	38
Blue Clay	38	65
Sand	65	70
Soft Grey Clay	70	85
Hard Dark Blue Clay	85	155
Sand	155	158
Blue Clay	158	125
Sand	125	186
Light Blue Clay	186	200
Circulation Loss	200	230
Sand & Clay Breaks	260	282
Sand	282	286
Sand & Clay Breaks	286	320
Blue Clay	320	406
Fine Sand	406	420
Clay	420	422
Sand-Grey	422	444
Blue Clay	444	475

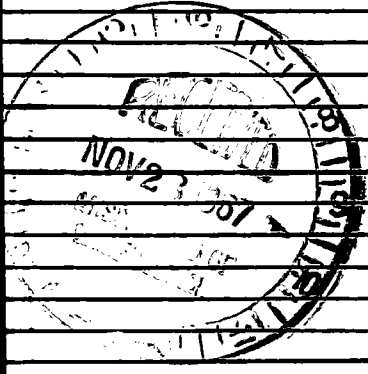

DRILLERS REMARKS:

If well telescopes please sketch and show depths.

GROUND LEVEL

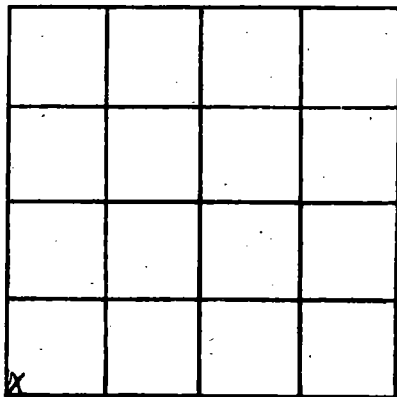

SECTION 9

Please indicate well location X.

ADDITIONAL INFORMATION

If more than one screen, show locations of each on sketch.