

**MISSISSIPPI
BOARD OF WATER COMMISSIONERS**
416 North State Street
Jackson, Mississippi 39201

CODED

WATER WELL DRILLERS LOG

Harrison
0117
11-67

11-1 1967
date well completed

Sutter Well Works
firm name

Harrison
county well located

LANDOWNER: Ray Collins
Cuevas, Miss

(mailing address)

WELL LOCATION:

8 sec 8 T 8 S R 12 E W
miles 1 1/2 IN Cuevas
(distance) (direction) (nearest town)

WELL PURPOSE: Home
(home, irrigation, municipal, industrial)

WELL COMPLETION DATA:

- (1) diameter (inches) 2
- (2) total depth (feet) 600
- (3) static water level (feet) 4 below
top of ground.
- (4) casing Galv. 590'
(material) (depth)
2"
(size) if telescope see back.
- (5) screen 10' 590'
(length) (depth to top)
2" stainless steel
(size) (material)
- (6) pump None
(HP) (yield gpm)

(type power)

(7) electric log no
(yes or no)

(organization running log)

(8) how well bottom plugged BP Valve


description of formations encountered

from

to

Clay	0	25
Sand	25	35
Clay	35	125
Clay - Sand streaks	125	210
Sand	210	225
Clay	225	260
Sand	260	280
Clay	280	395
Sand	395	432
Clay	432	521
Sand	521	600

CODED

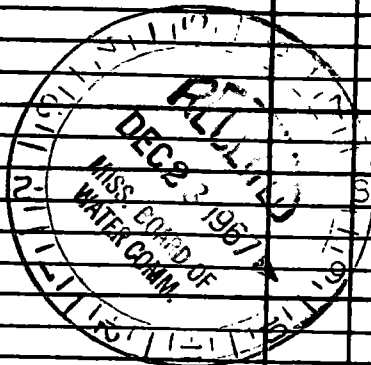

DRILLERS REMARKS:

If well telescopes please sketch and show depths.

GROUND LEVEL

X			

SECTION 8

Please indicate well location X.

ADDITIONAL INFORMATION

If more than one screen, show locations of each on sketch.