

HARRISON  
 0 120  
 5-68

MISSISSIPPI  
 BOARD OF WATER COMMISSIONERS  
 416 North State Street  
 Jackson, Mississippi 39201

CODED

WATER WELL DRILLERS LOG

5-17-68 19 date well completed  
 McB Drilling Co. firm name  
 Harrison county well located

LANDOWNER: J. W. King  
 Commission Rd.  
 Long Beach, Miss.  
 (mailing address)

WELL LOCATION:  
 sec. 2 T 8 R 12 E  
 S W  
 1 miles N of Long Beach  
 (distance) (direction) (nearest town)

WELL PURPOSE: Home  
 (home, irrigation, municipal, industrial)

WELL COMPLETION DATA:

- (1) diameter (inches) 2
- (2) total depth (feet) 270
- (3) static water level (feet) 8 below above top of ground.
- (4) casing PVC, 265 (material) (depth)  
 2" (size) if telescope see back.
- (5) screen 9 FT, 265 (length) (depth to top)  
 2" PVC Sand Pac. (size) (material)
- (6) pump 1 15 (HP) (yield gpm)  
 220V 1φ Shallow Well (type power) Let.
- (7) electric log No. (yes or no)
- (organization running log)
- (8) how well bottom plugged 2" PVC Cap

description of formations encountered	from	to
Surface	0	5
Sand	5	25
Dark Grey Clay	25	35
Light Blue Clay	45	60
Blue Clay	60	110
Sand & Clay Breaks	110	130
Blue Clay	130	152
Sand	152	160
Blue Clay	160	200
Sand	200	205
Blue Clay	205	252
Coarse Sand	252	267
Blue Clay	267	270

CODED


MAY 27 1968

MISS. BOARD OF  
 WATER COMM.

DRILLERS REMARKS:

If well telescopes please sketch and show depths.

GROUND LEVEL

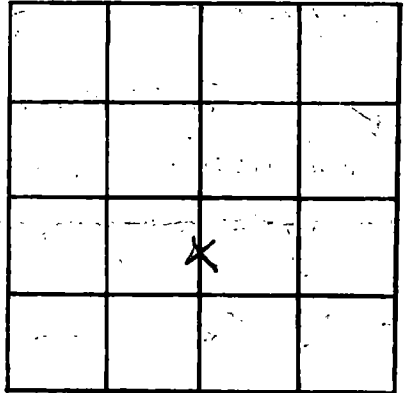

SECTION 2

Please indicate well location X.

ADDITIONAL INFORMATION

If more than one screen, show locations of each on sketch.