

Harrison
Φ 121
10-67


MISSISSIPPI
BOARD OF WATER COMMISSIONERS
416 North State Street
Jackson, Mississippi 39201

CODED

WATER WELL DRILLERS LOG

10-11 1967 Pineville Water Works Harrison
date well completed firm name county well located

LANDOWNER: Lee Davis Pt. 1 Pass Christian, Miss (mailing address)	description of formations encountered	from	to
		0	30
		35	348
WELL LOCATION: sec. 5 T. 8 N. R. 12 E. of <u>Cuba Miss</u> 1 miles N of <u>Cuba Miss</u> (distance) (direction) (nearest town)		348	393
WELL PURPOSE: <u>Home</u> (home, irrigation, municipal, industrial)			
WELL COMPLETION DATA: (1) diameter (inches) <u>2"</u> (2) total depth (feet) <u>393'</u> (3) static water level (feet) <u>4</u> <u>below</u> top of ground. (4) casing <u>9" gal</u> , <u>383'</u> (material) (depth) <u>None</u> if telescope see back. (size) (5) screen <u>10'</u> , <u>383</u> (length) (depth to top) <u>2"</u> , <u>1/2 on gal</u> (size) (material) (6) pump <u>1/2</u> (HP) (yield gpm) <u>elec</u> (type power) (7) electric log <u>None</u> (yes or no) <u>None</u> (organization running log) (8) how well bottom plugged <u>2" B.W.</u> <u>Value</u>			
DRILLERS REMARKS:			

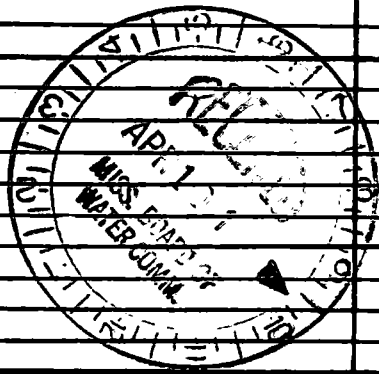

If well telescopes please sketch and show depths.

CL-1000

GROUND LEVEL

SECTION _____

Please indicate well location X.

ADDITIONAL INFORMATION

If more than one screen, show locations of each on sketch.