

Harrison
 122
 5-67

MISSISSIPPI
 BOARD OF WATER COMMISSIONERS
 416 North State Street
 Jackson, Mississippi 39201

WATER WELL DRILLERS LOG

CODED

5-24 1967 Pineville well 123 Harrison
 date well completed firm name county well located

LANDOWNER: Cliff Bazell
 Rt. 1
 Pass Christian, Miss.
 (mailing address)

WELL LOCATION:
 sec. 8 T. 8 N. R. 12 E.
 1 miles E of Pineville
 (distance) (direction) (nearest town)


WELL PURPOSE: Home
 (home, irrigation, municipal, industrial)

WELL COMPLETION DATA:

- (1) diameter (inches) 2"
- (2) total depth (feet) 428'
- (3) static water level (feet) 6' below top of ground.
- (4) casing Galv. 4 1/8' (material) (depth)
 If telescope see back.
 (size)
- (5) screen 10' 4 1/8' (length) (depth to top)
 2" Galv. on galv. (size) (material)
- (6) pump 1/8 (HP) (yield gpm)
 Ebe (type power)
- (7) electric log None (yes or no)
 None (organization running log)
- (8) how well bottom plugged 2" Back Wash Valve

description of formations encountered	from	to
top soil	0	15
Red sand & gravel	15	35
Red blue mud & clay	50	383
opp.	383	425
Cone Blue water sand		

CODED

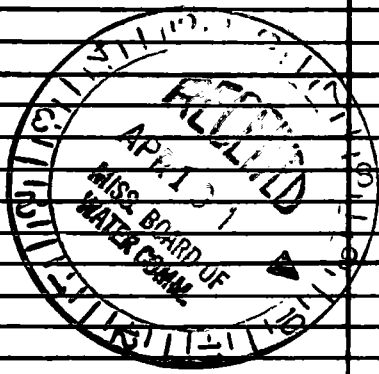

DRILLERS REMARKS:

If well telescopes please sketch and show depths.

GROUND LEVEL

SECTION _____

Please indicate well location X.

ADDITIONAL INFORMATION

If more than one screen, show locations of each on sketch.