

HAR.

Ø131

11-15-60

P447906

WATER WELL DRILLERS LOG

CODED

Date: 11-15, 1960, Driller: Joe Miller County Harrison
 (Name)

- (1) Owner of Land: JC Decaise
 (Name)
Rt 2 Box 220 Sulphur
 (Address)
- (2) Location: 1/4, 1/4, Sec. T R
20 812
 miles of
 (distance) (direction) (Nearest Town)
- (3) Topography: Hilly
 (Hilly) (Flat) (Level)
- (4) Purpose of Well: Domestic
 (Domestic Irrigation
 Municipal, Industrial, Other)

Description & Color of Materials Sand, Clay, Red Clay, Shell, etc.	Thick- ness Feet	Depth Feet
Surface	10	10
Wh Sand, tan Sand	45	55
Cl Sand Brownish	37	92
Blu Clay	56	248
Small Blush	3	25
7ld Blu Cl	57	308
Fine Gray Sand NG	28	336
7ld. Blu Clay	41	377
Fine Gray Sand	10	387
Gray Sand Shell	21	408
" " Red Sand	17	425
Sand got finer		430
Still Sand		

Information upon completion of well:


- (1) Diameter 2" inches.
- (2) Total Depth 425 feet.
- (3) Water Level 22' feet below top of ground.
- (4) Cased to 415, Size 2"
- (5) Screen: Size 24, Length 10'
- (6) Were any formations sealed against pollution?
 _____ yes, _____ no.

If YES depth of formation _____

Why _____

Drillers Remarks: _____


CODED

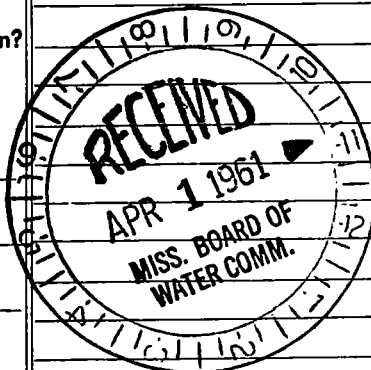

(Use Back Side)

Well No.

S

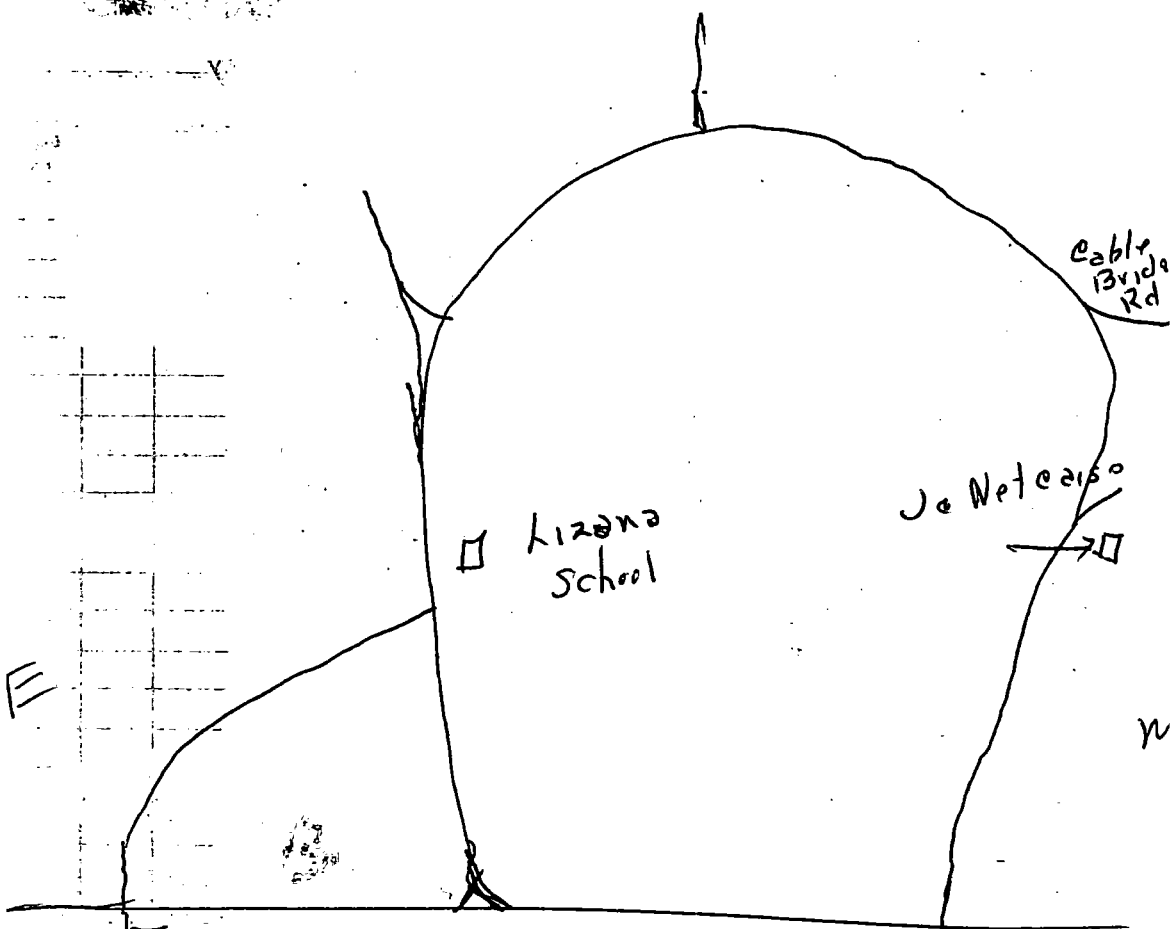

53 - HKy

N