

HARRISON
Ø 133
5-10-72

MISSISSIPPI
 BOARD OF WATER COMMISSIONERS
 416 North State Street
 Jackson, Mississippi 39201

CODED

WATER WELL DRILLERS LOG

5-10-72 19 R. J. Moore HARRISON
 date well completed firm name county well located

LANDOWNER: DONALD Banes
RT #1 Box 97
LONG BEACH, MISS
 (mailing address)

description of formations encountered	from	to
TOP SOIL	0	10
TOP SAND	16	30
WHITE CLAY	30	60
Red Clay	60	240
FINE SAND	240	260
Blue Clay	260	390
Blue Sand (med)	390	480

WELL LOCATION:
 sec. 4 T. 8 N. R. 12 E. W. 5
2 miles N of Fikeville
 (distance) (direction) (nearest town)

WELL PURPOSE:
 (home) irrigation, municipal, industrial

WELL COMPLETION DATA:
 (1) diameter (inches) 2"
 (2) total depth (feet) 450'
 (3) static water level (feet) 16' ^(below) _{above} top of ground.
 (4) casing Galv. 430'
 (material) (depth)
 (size) if telescope see back.
 (5) screen 2" x 10" 430'
 (length) (depth to top)
 (size) SS (material)
 (6) pump 1 9
 (HP) (yield gpm)
Ø
 (type power)
 (7) electric log
 (yes or no)

 (organization running log)
 (8) how well bottom plugged
Per 3/1/72

CODED


MAY 30 1972

DRILLERS REMARKS:

MISS. DEPT. OF
 WATER CONTROL

If well telescopes please sketch and show depths.

GROUND LEVEL

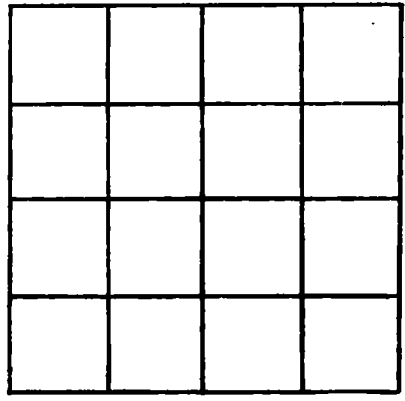

SECTION _____

Please indicate well location X.

ADDITIONAL INFORMATION

If more than one screen, show locations of each on sketch.