

HAR.  
Q134  
8-17-61

MISSISSIPPI BOARD OF WATER COMMISSIONERS

**CODED**

9 417 208

WATER WELL DRILLERS LOG

Date: 8-17, 1961, Driller: J. Reed County Harrison

(Name)

(1) Owner of Land:	Description & Color of Materials Sand, Clay, Red Clay, Shell, etc.	Thick- ness Feet	Depth Feet
<u>W.W. Watts</u> (Name)	<u>White sand</u>	<u>63</u>	<u>63</u>
<u>Rt 1 Box 174 Long beach</u> (Address)	<u>Soft mud</u>	<u>40</u>	<u>103</u>
<u>Base Sub Division</u> (Address)	<u>Dark Blue mud</u>	<u>200</u>	<u>303</u>
(2) Location: <u>1/4</u> , <u>1/4</u> , Sec. <u>T</u> <u>R</u>	<u>fine fine sand</u>	<u>30</u>	<u>333</u>
_____ miles _____ of _____	<u>Dark Blue mud</u>	<u>90</u>	<u>423</u>
(distance) (direction) (Nearest Town)	<u>Strate Concrete</u>	<u>48</u>	<u>471</u>
(3) Topography: _____ (Hilly) (Flat) (Level)	<u>Total ft well 471</u>		
(4) Purpose of Well: <u>Home</u> (Domestic Irrigation, Municipal, Industrial, Other)			

Information upon completion of well:


- (1) Diameter 2" x 1/4 inches.
- (2) Total Depth 471 feet.
- (3) Water Level 3 feet below top of ground.
- (4) Cased to \_\_\_\_\_, Size \_\_\_\_\_
- (5) Screen: Size 1/4, Length 15' 1/2
- (6) Were any formations sealed against pollution?  
Back filled white sand  
yes, \_\_\_\_\_ no.

If YES depth of formation \_\_\_\_\_

Why \_\_\_\_\_

Drillers Remarks: \_\_\_\_\_

**CODED**

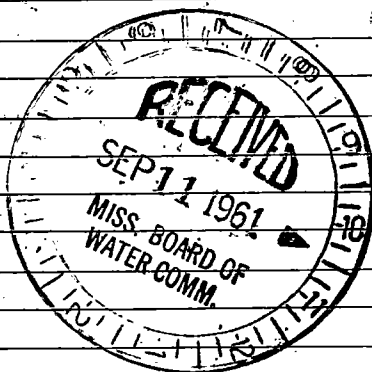

(Use Back Side)

Well No.

