

HAR.  
D137  
7-8-62

WATER WELL DRILLERS LOG

**CODED**

Date: July 8, 1962, Driller: Joe Miller County Harrison  
(Name)

(1) Owner of Land:	Description & Color of Materials Sand, Clay, Red Clay, Shell, etc.	Thick- ness Feet	Depth Feet
<u>John Dubussion</u> (Name)	<u>Surface</u>	<u>3</u>	<u>3</u>
<u>R.R.# Shepley Miss</u> (Address)	<u>White Sand</u>	<u>12</u>	<u>15</u>
(2) Location: <u>8 8 12</u> 1/4, 1/4, Sec. T. R.	<u>White Sand</u>	<u>13</u>	<u>28</u>
<u>5</u> miles <u>West</u> of <u>Shepley</u> (distance) (direction) (Nearest Town)	<u>Blue Clay</u>	<u>112</u>	<u>140</u>
(3) Topography: <u>Flat</u> (Hilly) (Flat) (Level)	<u>Sand Fine NG</u>	<u>8</u>	<u>148</u>
(4) Purpose of Well: <u>Domestic</u> (Domestic Irrigation Municipal, Industrial, Other)	<u>Clay &amp; Small Brcks.</u>	<u>20</u>	<u>168</u>
	<u>Sand (Fair)</u>	<u>10</u>	<u>178</u>
	<u>Sand (Fair)</u>	<u>11</u>	<u>189</u>
	<u>Sand (Fair)</u>	<u>5</u>	<u>196</u>
	<u>Clay (Hard)</u>	<u>2</u>	<u>198</u>

Information upon completion of well:

- (1) Diameter 2 inches.
- (2) Total Depth 196 feet.
- (3) Water Level 14' feet below top of ground.
- (4) Cased to 190, Size 2"
- (5) Screen: Size 2", Length 6'
- (6) Were any formations sealed against pollution?  
\_\_\_\_\_ yes, \_\_\_\_\_ no.


If YES depth of formation \_\_\_\_\_

Why \_\_\_\_\_

Drillers Remarks: \_\_\_\_\_

over


**CODED**

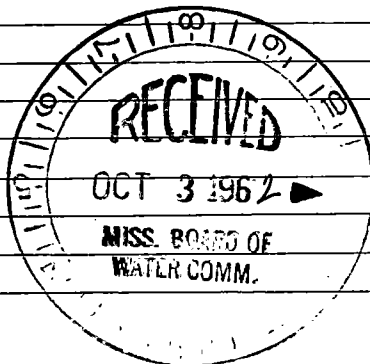

(Use Back Side)

Well No.

1920

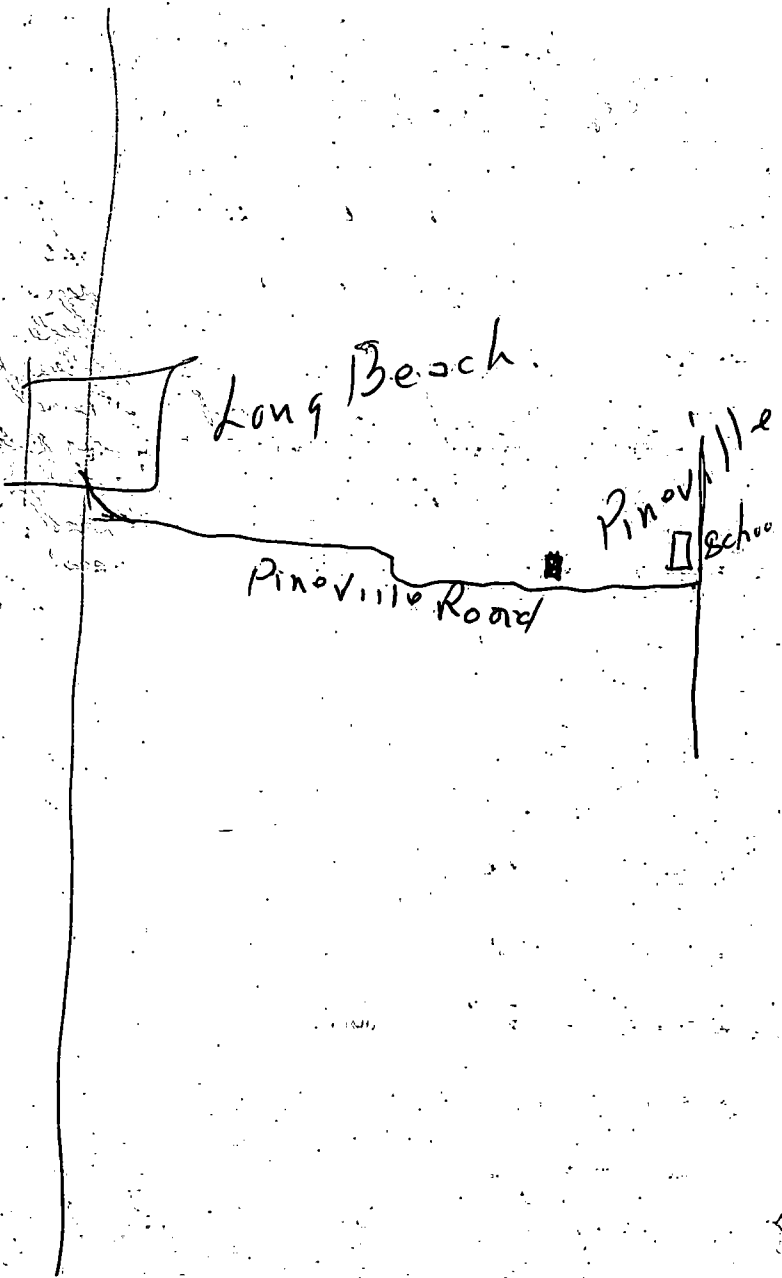

5