

E 453 201

WATER WELL DRILLERS LOG

CODED

HAR. 0138
8-2-62

Date: Aug 2, 1962, Driller: Joe Miller County Harrison
(Name)

(1) Owner of Land: C. B. Gates
(Name)
RR# Long Beach Miss
(Address) 5 8 12

(2) Location: 1/4, 5 8 12, Sec. 8 12, T. R,
5 miles North West of Long Beach,
(distance) (direction) (Nearest Town)

(3) Topography: Flat,
(Hilly) (Flat) (Level)

(4) Purpose of Well: Domestic
(Domestic Irrigation
Municipal, Industrial, Other)

Description & Color of Materials Sand, Clay, Red Clay, Shell, etc.	Thick- ness Feet	Depth Feet
Red Clay	5	5
Gray Clay	15	20
Blue Clay	81	101
Fine Sand	5	106
Blue Clay	4	110
Gray Silt (Fine)	16	126
Blue Clay	84	210
Gray Silt (Fine)	28	238
Hard Blue Clay	114	352
Gray Sand - Fine	38	390
Ad Clay - Blue	10	400
Gray Silt - Fine	20	420
Hard Blue Clay	58	478
Sand (Washed) - Fine	6	484
Sand " " - Fine	11	495
Sand " " - Med.	36	531
Ad Blue Clay	3	534

Information upon completion of well:

(1) Diameter 2" inches.

(2) Total Depth 534' feet.

(3) Water Level Flowing feet below top of ground.

(4) Cased to 521', Size 2"

(5) Screen: Size 2", Length 10'


(6) Were any formations sealed against pollution?
_____ yes, _____ no.

If YES depth of formation _____

Why _____


Drillers Remarks: _____

CODED

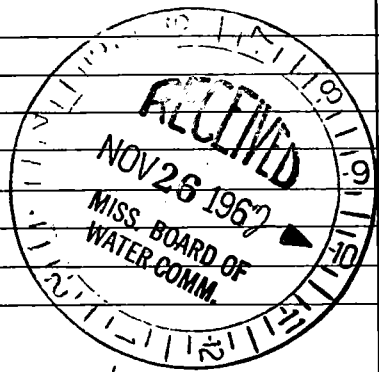

(over) (Use Back Side)

Well No.

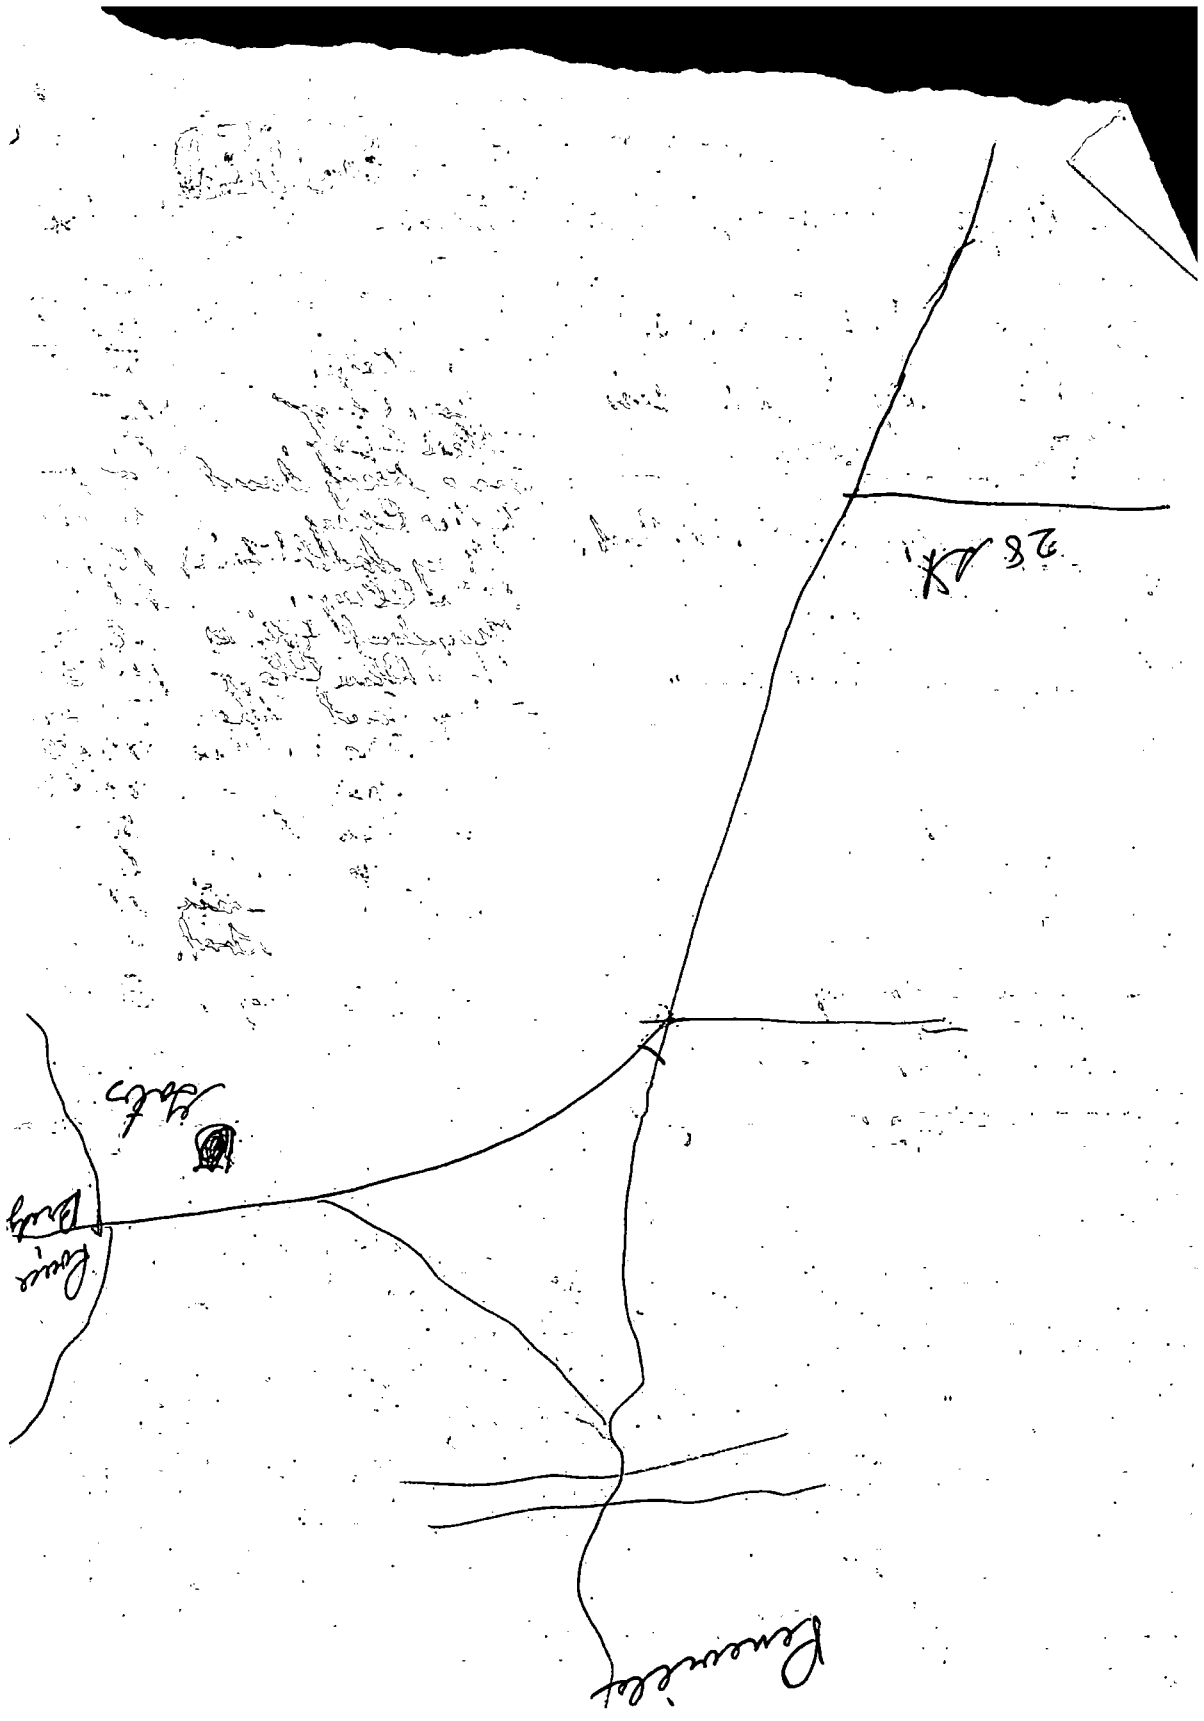

28 A.

Hatch



Lower
Bridge

Pomeroy