

HAR.

142

WATER WELL DRILLERS LOG

CODED

8-25-61

Date: 8-25, 1961, Driller: C. T. SWITZER WELL CO. County Harrison

(Name)

(1) Owner of Land:

Leo Autler

(Name)

(2) Location:

1/4, 10, 8 12, Sec. T. R.

miles of (distance) (direction) (Nearest Town)

(3) Topography:

X (Hilly) (Flat) (Level)

(4) Purpose of Well:

Domestic (Domestic Irrigation, Municipal, Industrial, Other)

Description & Color of Materials Sand, Clay, Red Clay, Shell, etc.	Thick- ness Feet	Depth Feet
sand	8	54
clay	54	162
fine sand	162	176
clay	176	262
good sand	262	299

CODED


Information upon completion of well:

- (1) Diameter 2" inches.
- (2) Total Depth 299 feet.
- (3) Water Level 13' feet below top of ground.
- (4) Cased to 299', Size 2".
- (5) Screen: Size 2", Length 10'.
- (6) Were any formations sealed against pollution?
X yes, no.

If YES depth of formation

Why Health Dept Requirement

Drillers Remarks:

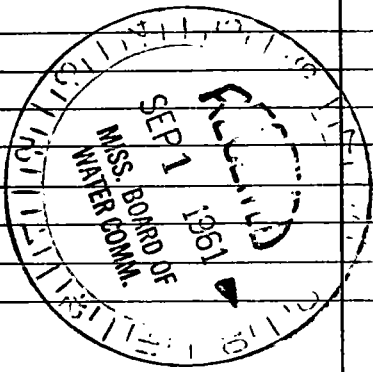

(Use Back Side)

Well No.

WATER WELL DATA SHEET

Project Name: _____ Date: _____

(1) Owner of Well: _____
Address: _____
City: _____

(2) Location of Well: _____
Elevation: _____
Depth: _____

(3) Purpose of Well: _____
Type of Well: _____
Depth: _____

Information upon completion of well:
(1) Diameter: _____

(2) Total depth: _____

(3) Water level: _____ feet below top of ground.

(4) Kind and size of casing: _____

(5) Screen size and length: _____

(6) Were any functions tested against pollution?

If YES depth of penetration: _____

Why? _____

Driller's Remarks: _____