

HARRISON
 147
 7-19-71

MISSISSIPPI
 BOARD OF WATER COMMISSIONERS
 416 North State Street
 Jackson, Mississippi 39201

FEB 14 1972

WATER WELL DRILLERS LOG

MISS. BD. OF
 WATER COMM.

7/19/71 1971 McCall Well Works Harrison
 date well completed firm name county well located

LANDOWNER: David Graham
Rt. 1, Box 555
Gulfport, Miss.
 (mailing address)

description of formations encountered	from	to
topsoil	2	7
clay	7	30
sand	30	165
clay	165	210
slush	210	335
Blue clay	335	430
sand	430	455

WELL LOCATION:
 sec. 3 T. 8 N. R. 12 E
1 1/2 miles SW of Long Beach
 (distance) (direction) (nearest town)

WELL PURPOSE: Private
 (home, irrigation, municipal, industrial)


- WELL COMPLETION DATA:
- (1) diameter (inches) 4.55 ^{1 1/2"}
 - (2) total depth (feet) 455
 - (3) static water level (feet) 3' below above top of ground.
 - (4) casing gal. 445'
 (material) (depth)
 (size) If telescope see back.
 - (5) screen 10' 2"
 (length) (depth to top) (size) 5-5
 (material)
 - (6) pump 1 7
 (HP) (yield gpm)
electric
 (type power)
 - (7) electric log no
 (yes or no)
 (organization running log)
 - (8) how well bottom plugged sand
1/2 inch

CODED

DRILLERS REMARKS:

If well telescopes please sketch and show depths.

GROUND LEVEL

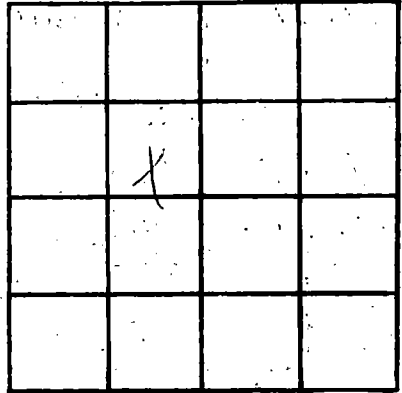

SECTION 3

Please indicate well location X.

ADDITIONAL INFORMATION

If more than one screen, show locations of each on sketch.