

HARRISON  
 151  
 8-2-72

MISSISSIPPI  
 BOARD OF WATER COMMISSIONERS  
 416 North State Street  
 Jackson, Mississippi 39201

**CODED**

WATER WELL DRILLERS LOG

Aug 2 1972 *R. McGill well works* Harrison  
 date well completed firm name county well located

LANDOWNER: *G. Stuart Rowley*  
 *Rt. 1, Box 647*  
 *Gulfport, Miss.*  
 (mailing address)

description of formations encountered	from	to
<i>topsoil</i>	<i>0</i>	<i>20</i>
<i>clay</i>	<i>30</i>	<i>20</i>
<i>Blue clay</i>	<i>120</i>	<i>184</i>
<i>sand</i>	<i>184</i>	<i>280</i>

WELL LOCATION:  
 sec. 9 T. 8 N R. 12 E  
4 miles W of Gulfport  
 (distance) (direction) (nearest town)

WELL PURPOSE: *none*  
 (home, irrigation, municipal, industrial)

WELL COMPLETION DATA:

- (1) diameter (inches) 280
- (2) total depth (feet) 275
- (3) static water level (feet) 3' below above top of ground.
- (4) casing gal. 270  
 (material) (depth)  
10 If telescope see back.  
 (size)
- (5) screen 10' 10'  
 (length) (depth to top)  
2" steel S.S.  
 (size) (material)
- (6) pump 1 5  
 (HP) (yield gpm)  
electric  
 (type power)
- (7) electric log no.  
 (yes or no)  
no  
 (organization running log)
- (8) how well bottom plugged sand  
sharp

**CODED**


SEP 5 1972

DRILLERS REMARKS:

If well telescopes please sketch and show depths.

COPIED

GROUND LEVEL

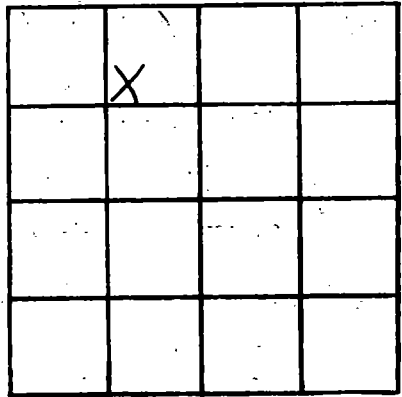

SECTION 9

Please indicate well location X.

ADDITIONAL INFORMATION

COPIED

If more than one screen, show locations of each on sketch.