

**HARRISON**  
**Ø 155**  
**9-30-72**

MISSISSIPPI  
 BOARD OF WATER COMMISSIONERS  
 41 **CODED** Street  
 Jackson, Mississippi 39201

**WATER WELL DRILLERS LOG**

9-30- 1972 J.T. WARD WATER WELLS HARRISON  
 date well completed firm name county well located

LANDOWNER: JOSEPH HILBY, JR.

description of formations encountered

from to

110 JAMAICA

Top Soil-clay

0 21

Long Beach, Miss.  
 (mailing address)

sd

21 32

WELL LOCATION:

sec. 3 T. 8 N. R. 12 E.  
2 miles NE of LONG BEACH  
 (distance) (direction) (nearest town)

gray clay

32 96

sd

96 168

clay

108 176

sd-clay

176 188

Breakdown-clay

188 374

sd & fine

374 392

blue clay

392 422

sd.

422 451

WELL PURPOSE: HOME  
 (home, irrigation, municipal, industrial)

WELL COMPLETION DATA:

(1) diameter (inches) 2

(2) total depth (feet) 451

(3) static water level (feet) 8 below above top of ground.

(4) casing 2" Galv. 441  
 (material) (depth)

**CODED**

- if telescope see back.  
 (size)

(5) screen 10' -  
 (length) (depth to top)

2" S.S.  
 (size) (material)

(6) pump 1/2 8  
 (HP) (yield gpm)

Elec.  
 (type power)

(7) electric log NO  
 (yes or no)

N/A  
 (organization running log)

(8) how well bottom plugged GW.


OCT 1 1972

DRILLERS REMARKS: N/A

WATER

If well telescopes please sketch and show depths.

GROUND LEVEL

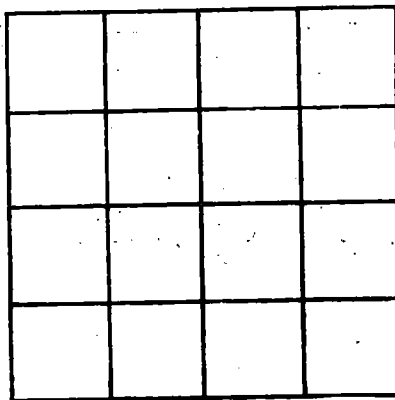

SECTION 3

Please indicate well location X.

ADDITIONAL INFORMATION

If more than one screen, show locations of each on sketch.