

HARRISON
 156
 11-1-72

MISSISSIPPI
 BOARD OF WATER COMMISSIONERS
 416 North State Street
 Jackson, Mississippi 39201
WATER WELL DRILLERS LOG

11-1 19 72 Sutter Well Works Harrison
 date well completed firm name county well located

LANDOWNER: A.J.M. Oustalet, Jr. 753 East Beach Pass Christian, Miss. (mailing address)	Description of formations encountered	from	to
	Clay & sand streaks	0	160
	Sand	160	190
	Clay	190	202
	Sand	202	231
	Clay	231	505
	Sand	505	533
	Clay	533	546
	Sand	546	575
	Clay	575	614
	Sand	614	692
WELL LOCATION:			
sec. 17 T 8 N R 12 E in Pass Christian (distance) miles (direction) of (nearest town)			
WELL PURPOSE: home (home, irrigation, municipal, industrial)			
WELL COMPLETION DATA:			
(1) diameter (inches) 3" x 4"			
(2) total depth (feet) 692'			
(3) static water level (feet) 0' below top of ground.			
(4) casing steel 672' (material) (depth) 3" & 4" If telescope see back. (size)			
(5) screen 20' 672' (length) (depth to top) 3" stainless steel (size) (material)			
(6) pump 3 75 (HP) (yield gpm) elec. (type power)			
(7) electric log no (yes or no) (organization running log)			
(8) how well bottom plugged B.P. Valve NOV 17 1972			
DRILLERS REMARKS:			

If well telescopes please sketch and show depths.


GROUND LEVEL

63' of 4" black casing

6" x 4" swaged nipple

589' of 3" black casing

3" x 20' stainless steel
strainer 10 gauge

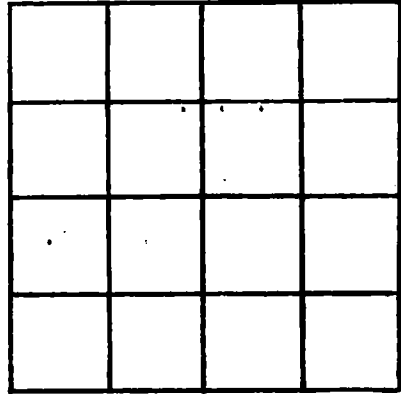

SECTION _____

Please indicate well location X.

ADDITIONAL INFORMATION

If more than one screen,
show locations of each on sketch.