

HARRISON
 0158
 4-4-72

MISSISSIPPI
 BOARD OF WATER COMMISSIONERS
 416 North State Street
 Jackson, Mississippi 39201

WATER WELL DRILLERS LOG

April 4 19 92 McNeil Well Work Harrison
 date well completed firm name county well located

LANDOWNER: Louis Baral
 Bosarge Road
 Gulfport Miss.
 (mailing address)

WELL LOCATION:
 sec. 4 T. 8 N R. 12 E
 S W
 3 miles W of Long Beach
 (distance) (direction) (nearest town)

WELL PURPOSE: Home
 (home, irrigation, municipal, industrial)


- WELL COMPLETION DATA:
- (1) diameter (inches) 2"
 - (2) total depth (feet) 713'
 - (3) static water level (feet) 3' below top of ground.
 - (4) casing gal. gal. 703' (material) (depth)
 - (size) If telescope see back.
 - (5) screen 10' (length) (depth to top)
 - 2" (size) 5.5. (material)
 - (6) pump 1 (HP) 8 (yield gpm)
 - Electric (type power)
 - (7) electric log no (yes or no)
 - no. (organization running log)
 - (8) how well bottom plugged good

Description of formations encountered	from	to
well put off road.		
clay	0	25
sand	25	45
clay	45	160
fine sand	160	190
clay	190	408
fine sand	408	432
clay	432	580
fine sand	580	663
course sand	663	713

DRILLERS REMARKS:

If well telescopes please sketch and show depths.

GROUND LEVEL

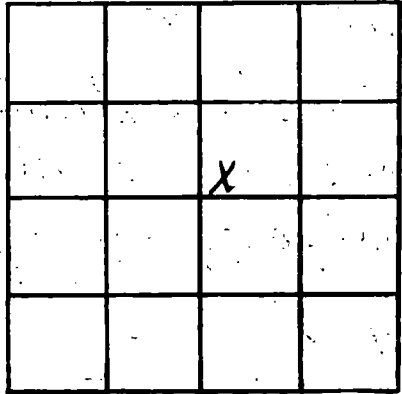

SECTION 4

Please indicate well location X.

ADDITIONAL INFORMATION

If more than one screen, show locations of each on sketch.