

HARRISON

Ø 160

11-4-72

MISSISSIPPI BOARD OF WATER COMMISSIONERS 416 North State Street Jackson, Mississippi 39201

CODED

WATER WELL DRILLERS LOG

Nov. 4

1972 Mc Mill Well Works

Harrison

date well completed

firm name

county well located

LANDOWNER: Bob Reno

211 white Harbor Rd.

Long Beach Miss. (mail/hq address)

description of formations encountered

from

to

topsoil

0

2

clay

2

18

fine sand

18

136

course sand

136

189

WELL LOCATION:

sec. 10 T. 8 N R. 12 E 1 1/2 miles N.E of Long Beach (distance) (direction) (nearest town)

WELL PURPOSE: golf course (home, irrigation, municipal, industrial)

WELL COMPLETION DATA:

- (1) diameter (inches) 2"
(2) total depth (feet) 189'
(3) static water level (feet) below/above top of ground.
(4) casing gal. 179' (material) (depth)
(5) screen 10' (length) (depth to top) 2" (size) plastic (material)
(6) pump 1/2 (HP) 8 (yield gpm) electric (type power)
(7) electric log NO (yes or no)
(8) how well bottom plugged sand shark


CODED

DRILLERS REMARKS:

JAN 20 1973

If well telescopes please sketch and show depths.

GROUND LEVEL

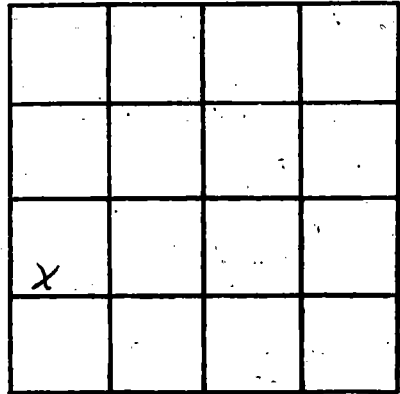

SECTION 10

Please indicate well location X.

ADDITIONAL INFORMATION

If more than one screen, show locations of each on sketch.