

HARRISON
 D 170
 3-6-72

MISSISSIPPI
 BOARD OF WATER COMMISSIONERS
 416 North State Street
 Jackson, Mississippi 39201

WATER WELL DRILLERS LOG

CODED

March 6 1972 MS Mill Well Works Harrison
 date well completed firm name county well located

LANDOWNER: Charles Donald

542 St. Louis St.

Poss Christina Miss.
 (mailing address)

WELL LOCATION:

sec. 4 T 8 N R 12 E
 S W
 7 1/2 miles N.E. of Poss Christina
 (distance) (direction) (nearest town)

WELL PURPOSE: Home
 (home, irrigation, municipal, industrial)

WELL COMPLETION DATA:

- (1) diameter (inches) 2"
 (2) total depth (feet) 609'
 (3) static water level (feet) 9" below top of ground.

(4) casing gal. 599'
 (material) (depth)

(size) If telescope see back.

(5) screen 10'
 (length) (depth to top)

2" plaster
 (size) (material)

(6) pump NO pump. 1 Day
 (HP) (yield gpm)
 Installed there own. well

(7) electric log NO
 (yes or no)

(organization running log)

(8) how well bottom plugged sand
 shark

Description of formations encountered	from	to
topsoil	0	2
clay	2	18
sand	18	61
clay	61	147
pink sand	147	182
slush	182	247
clay	247	310
fine sand	310	352
clay	352	389
slush	389	415
clay	415	467
fine sand	467	492
course sand	492	510
clay	510	578
course sand	578	609


CODED

yield 1/2 to 1 gal.
 with 1 horse pump.

DRILLERS REMARKS:

If well telescopes please sketch and show depths.

GROUND LEVEL

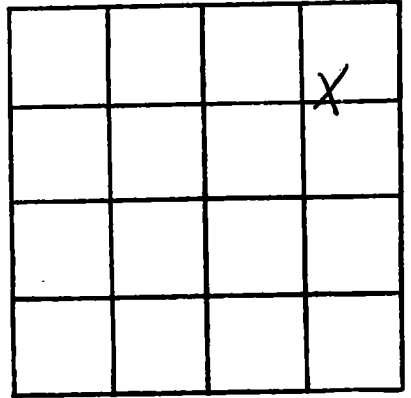

SECTION 4

Please indicate well location X.

ADDITIONAL INFORMATION

If more than one screen,
show locations of each on sketch.