

Harrison
0192
6-24-69

MISSISSIPPI
 BOARD OF WATER COMMISSIONERS
 416 North State Street
 Jackson, Mississippi 39201

CODED

WATER WELL DRILLERS LOG

6-24-69 19 R. V. Moore HARRISON
 date well completed firm name county well located

LANDOWNER: Fred Hoff

description of formations encountered	from	to
<u>TOP SOIL</u>	<u>0</u>	<u>17</u>
<u>White SAND & gravel</u>	<u>17</u>	<u>25</u>
<u>Blue CLAY</u>	<u>25</u>	<u>50</u>
<u>FINE SILTY SAND</u>	<u>50</u>	<u>65</u>
<u>Blue CLAY</u>	<u>65</u>	<u>90</u>
<u>Blue SAND (USABLE)</u>	<u>90</u>	<u>110</u>
<u>Blue CLAY</u>	<u>110</u>	<u>122</u>
<u>Blue SAND (Med)</u>	<u>122</u>	<u>200</u>

COMMISSIONER RD Box 620

LONG BEACH, MISS
 (mailing address)

WELL LOCATION:

sec. 12 T. 8 N R. 12 E
S W
CITY LONG BEACH, MISS
 (distance) miles (direction) of (nearest town)

WELL PURPOSE: Home
 (home) Irrigation, municipal, industrial

WELL COMPLETION DATA:

- (1) diameter (inches) 2"
- (2) total depth (feet) 200'
- (3) static water level (feet) 19' below above top of ground
- (4) casing Galv., 188'
 (material) (depth)
 (size) If telescope see back.
- (5) screen 10, 188"
 (length) (depth to top)
2", SS
 (size) (material)
- (6) pump 1, 620
 (HP) (yield gpm) nc
6 Lec
 (type power)
- (7) electric log
 (yes or no)

(organization running log)

(8) how well bottom plugged B.W
Valve


DRILLERS REMARKS:
DID NOT DRILL TO
BOTTOM OF SAND

JUL 7 - 1969

MISS. BD. OF
 WATER COM.

If well telescopes please sketch and show depths.

GROUND LEVEL

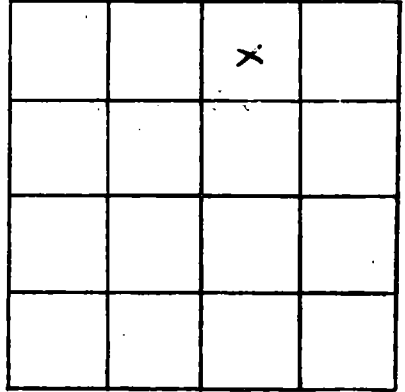

SECTION 12

Please indicate well location X.

ADDITIONAL INFORMATION

If more than one screen, show locations of each on sketch.