

**MISSISSIPPI
BOARD OF WATER COMMISSIONERS**
416 North State Street
Jackson, Mississippi 39201

CODED

CODED

WATER WELL DRILLERS LOG

198
7-3-69

7-3 1969 Water Well Works Harrison
date well completed firm name county well located

LANDOWNER: H.C. Elrod
Rt 1 Box 109-C
LONG BEACH, Miss.
(mailing address)

description of formations encountered	from	to
<u>Clay</u>	<u>0</u>	<u>16</u>
<u>Sand</u>	<u>16</u>	<u>22</u>
<u>Clay - sand streaks</u>	<u>22</u>	<u>300</u>
<u>Old</u>	<u>300</u>	<u>419</u>
<u>sand</u>	<u>419</u>	<u>442</u>

WELL LOCATION:
sec. 3 T. 8 S. R. 12 E.
3 miles NW of Long Beach
(distance) (direction) (nearest town)

WELL PURPOSE: home
(home, irrigation, municipal, industrial)

- WELL COMPLETION DATA:
- diameter (inches) 2 x 4
 - total depth (feet) 442
 - static water level (feet) 8" below above top of ground.
 - casing galv 427
(material) (depth)
2 x 4 if telescope see back.
(size)
 - screen 15' 427'
(length) (depth to top)
2" Stainless steel
(size) (material)
 - pump unknown
(HP) (yield gpm)
(type power)
 - electric log no
(yes or no)
(organization running log)
 - how well bottom plugged BPI's log

DRILLERS REMARKS:

JAN 12 1970

If well telescopes please sketch and show depths.


GROUND LEVEL

105' of 4" galv.

322' of 2" galv

2 x 15 Strainer

If more than one screen, show locations of each on sketch.

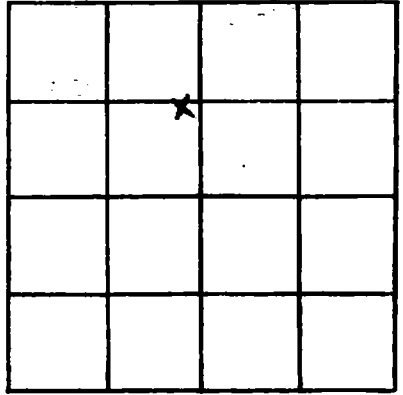

3

SECTION _____

Please indicate well location X.

ADDITIONAL INFORMATION

Lined area for additional information.