

Harrison
 203
 3-31-70

MISSISSIPPI
 BOARD OF WATER COMMISSIONERS
 416 North State Street
 Jackson, Mississippi 39201

CODED

WATER WELL DRILLERS LOG

March 31 1970 McCall Well Works Harrison
 date well completed firm name county well located

LANDOWNER: Larry Beaver
Box 85A SB. Ave.
Long Beach, Miss.
 (mailing address)

description of formations encountered	from	to
<u>Top Soil</u>	<u>0'</u>	<u>10'</u>
<u>Mud</u>	<u>10'</u>	<u>30'</u>
<u>LINE-STRAW-LIMBS</u>	<u>30'</u>	<u>60'</u>
<u>LINE BARKS</u>		
<u>shells</u>	<u>20'</u>	<u>110'</u>
<u>slush</u>	<u>110'</u>	<u>480'</u>
<u>SAND</u>	<u>480'</u>	<u>547'</u>

WELL LOCATION:
 sec 4 T 8 N R 12 E
6 miles West of Long Beach
 (distance) (direction) (nearest town)

WELL PURPOSE: Home
 (home, irrigation, municipal, industrial)

WELL COMPLETION DATA:

- (1) diameter (inches) 2"
- (2) total depth (feet) 547'
- (3) static water level (feet) Above below top of ground
- (4) casing No (material) (depth)
No if telescope see back. (size)
- (5) screen 10' (length) (depth to top)
2" (size) S.S. (material)
- (6) pump 1/2 (HP) 289 p.m. (yield gpm)
Electric (type power)
- (7) electric log No (yes or no)
No (organization running log)
- (8) how well bottom plugged Sand
SHARKS

CODED


APR 10 1970

MISS. BD. OF
 WATER COMM.

DRILLERS REMARKS: A Real
good flow.

If well telescopes please sketch and show depths.

GROUND LEVEL

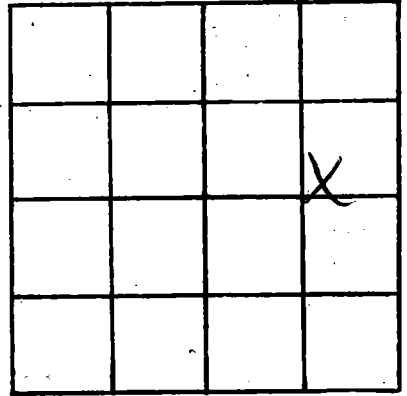

SECTION 4

Please indicate well location X.

ADDITIONAL INFORMATION

If more than one screen, show locations of each on sketch.