

On 5/8/69

2nd 5/21/70

Jay Kent 6/11/70

MISSISSIPPI BOARD OF WATER COMMISSIONERS
416 North State Street
Jackson, Mississippi 39201

CODED

WATER WELL DRILLERS LOG

Harrison
0207
4-15-70
5

4/15 date well completed
1969 COASTAL DRILLING firm name
HARRISON county well located

LANDOWNER: Roberts E.
Frank W. Peale Rd
Joy Beach, Miss.
(mailing address)

| description of formations encountered | from | to |
|---------------------------------------|------|-----|
| Red clay | 15 | 15 |
| Loam | 15 | 100 |
| Blue clay | 100 | 150 |
| fine blue sand | 150 | 210 |
| Very coarse sand | 210 | 246 |

WELL LOCATION:
[Redacted] 209
1980 miles W Joy Beach
(distance) (direction) (nearest town)

WELL PURPOSE: Home
(home, irrigation, municipal, industrial)

- WELL COMPLETION DATA:
- (1) diameter (inches) 2
 - (2) total depth (feet) 246
 - (3) static water level (feet) 40 below top of ground
 - (4) casing 2" gal (material), 236 (depth)
 - (5) screen 10' (length), 236 (depth to top)
2" (size), SS (material)
 - (6) pump 1 HP (HP), 22 gal (yield gpm)
E.C. (type power)
 - (7) electric log (yes or no)

(8) how well bottom plugged 2" BW good


DRILLERS REMARKS:
None

MAY 6 - 1970

MISS. BD. OF

If well telescopes please sketch and show depths.

GROUND LEVEL

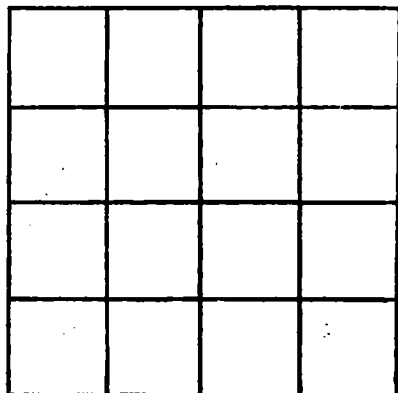

SECTION _____

Please indicate well location X.

ADDITIONAL INFORMATION

If more than one screen, show locations of each on sketch.